

MISSISSIPPI DEPARTMENT OF NATURAL RESOURCES

Bureau of Land and Water Resources

Southport Mall

P.O. Box 10631

Jackson, Mississippi 39209

WATER WELL DRILLERS LOG

Jackson
F 2064

9-9-83

Coast Water Well Sew.

Jackson

date well completed

firm name

county well located

LANDOWNER:

Shirley L. Borgen
Rt 2 - Box P-66

description of formations encountered

from

to

Clean Springs, Miss.
(mailing address) 37564

Top soil

0 2'

Red Clay

7' 15'

WELL LOCATION:

sec 29 T 5 S R 7 E
3 miles NNW of Vandeventer
(distance) (direction) (nearest town)

Gray Clay

15' 43'

Red coarse sand & gravel

43' 107'

WELL PURPOSE:

(home, irrigation, municipal, industrial)

Home

Blue Clay

107' 217'

WELL COMPLETION DATA:

- (1) diameter (inches) 2"
- (2) total depth (feet) 268'
- (3) static water level (feet) 68' below top of ground.
- (4) casing PVC 258'
(material) (depth)
2" if telescope see back.
(size)
- (5) screen 10' 258'
(length) (depth to top)
2" PVC
(size) (material)
- (6) pump 1/2 HP 7
(HP) (yield gpm)
Electric
(type power)
- (7) electric log Yes
(yes or no)

Gray coarse sand 217' 258'

Blue Clay

258' 268'

(organization running log)

(8) how well bottom plugged

Backwash valve


DRILLERS REMARKS:

DEPT. OF NATURAL RESOURCES
BUREAU OF LAND & WATER RESOURCES

OCT 14 1983
RECEIVED

If well telescopes please sketch and show depths.

GROUND LEVEL

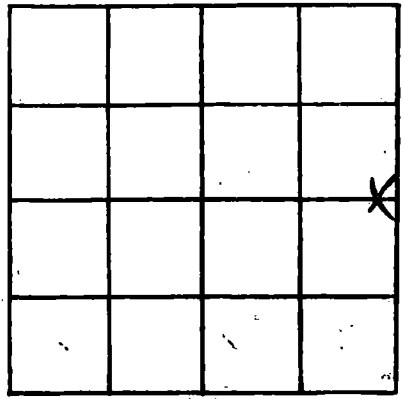

SECTION 29

Please indicate well location X.

ADDITIONAL INFORMATION

If more than one screen, show locations of each on sketch.