

MISSISSIPPI DEPARTMENT OF NATURAL RESOURCES

Bureau of Land and Water Resources

Southport Mall

P.O. Box 10631

Jackson, Mississippi 39209

WATER WELL DRILLERS LOG

Jackson
F2065

9-21-83

Coast Water Well Serv. Jackson

date well completed

firm name

county well located

George & Karen Hudson
OWNER

Rt 2 Box 222

Acorn Springs, Miss.
(mailing address) 39568

description of formations encountered

from to

Top soil 0 2'

Red clay 2' 15'

Purple clay 15' 30'

Gray clay 30' 45'

Blue clay 45' 80'

Red coarse sand 80' 110'

Blue clay 110' 230'

Gray coarse sand 230' 286'

Blue clay 286' 296'

WELL LOCATION:

sec. 20 T 5 N R 7 E
4 miles N of Vandevine
(distance) (direction) (nearest town)

WELL PURPOSE: Home
(home, irrigation, municipal, industrial)

WELL COMPLETION DATA:

- (1) diameter (inches) 2"
- (2) total depth (feet) 296'
- (3) static water level (feet) 107' ^{below}/_{above} top of ground.
- (4) casing PVC 286' (material) (depth)
- (5) screen 5" (size) If telescope see back.
- (6) screen 10' 286' (length) (depth to top)
- (7) pump 2" PVC (size) (material)
- (8) pump 2 h.p. = 4- (HP) (yield gpm)
- (9) electric log No. (type power) (yes or no)

(organization running log)

(8) how well bottom plugged
Back Wash Valve

DRILLERS REMARKS:


DEPT. OF NATURAL RESOURCES
BUREAU OF LAND & WATER RESOURCES

007 14 983

RECEIVED

If well telescopes please sketch and show depths.

GROUND LEVEL

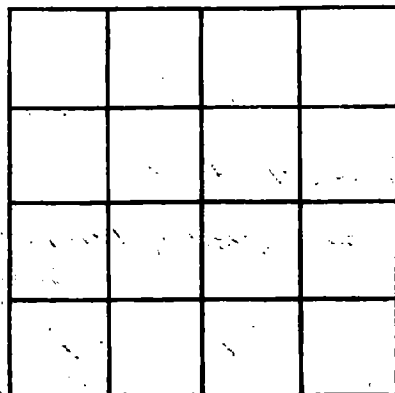

SECTION _____

Please indicate well location X.

ADDITIONAL INFORMATION

If more than one screen, show locations of each on sketch.