

MISSISSIPPI DEPARTMENT OF NATURAL RESOURCES

Bureau of Land and Water Resources

Southport Mall

P.O. Box 10631

Jackson, Mississippi 39209

WATER WELL DRILLERS LOG

Jackson
F 2067

11-15-83 19 Cross Water Well Sew. Jackson
date well completed firm name county well located

LANDOWNER Rud Long
Rt 2 - Box 177 NO
Ocean Springs, Miss
(mailing address) 3564

description of formations encountered	from	to
<u>Top soil</u>	<u>0</u>	<u>5'</u>
<u>Red Clay</u>	<u>5'</u>	<u>27'</u>
<u>Red coarse sand</u>	<u>27'</u>	<u>74'</u>
<u>Blue Clay</u>	<u>74'</u>	<u>263'</u>
<u>Gray coarse sand</u>	<u>263'</u>	<u>305'</u>

WELL LOCATION:
sec. 23 T. 5 S. R. 7 E.
4 1/2 miles NE of VAN CLEAVE
(distance) (direction) (nearest town)

WELL PURPOSE: home
(home, irrigation, municipal, industrial)

WELL COMPLETION DATA:

(1) diameter (inches) 2"

(2) total depth (feet) 305'

(3) static water level (feet) 114' below top of ground.

(4) casing PVC, 295'
(material) (depth)

2" If telescope see back.
(size)

(5) screen 10', 295'
(length) (depth to top)

2", PVC
(size) (material)

(6) pump _____ (HP) _____ (yield gpm)

Elect.
(type power)

(7) electric log No.
(yes or no)

(organization running log)

(8) how well bottom plugged back wash water

DRILLERS REMARKS:


DEPT. OF NATURAL RESOURCES
BUREAU OF LAND & WATER RESOURCES

MAR - 1 1984

RECEIVED

If well telescopes please sketch and show depths.

GROUND LEVEL

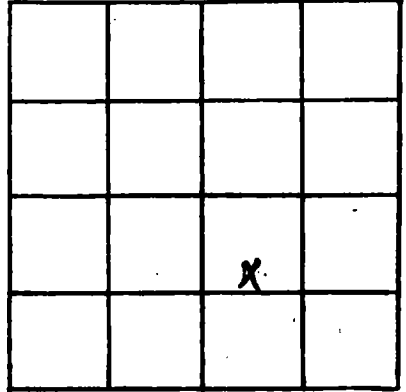

SECTION 23

Please indicate well location X.

ADDITIONAL INFORMATION

If more than one screen, show locations of each on sketch.