

MISSISSIPPI DEPARTMENT OF NATURAL RESOURCES

Bureau of Land and Water Resources

Southport Mall

P.O. Box 10631

Jackson, Mississippi 39209

WATER WELL DRILLERS LOG

Jackson  
F 2068

3-24 1984 Coast Water Well Sw. Jackson  
date well completed firm name county well located

LANDOWNER:	Description of formations encountered	from	to
<u>Roderick J. Williams</u>	<u>Top Soil</u>	<u>0</u>	<u>3'</u>
<u>P.O. Box 1246</u>	<u>Red Clay</u>	<u>3'</u>	<u>16'</u>
<u>Escatawpa, Ms.</u> (mailing address)	<u>Red Coarse Sand</u>	<u>16'</u>	<u>65'</u>
WELL LOCATION: sec <u>23</u> T <u>5</u> S R <u>7</u> W <u>5</u> miles <u>NE</u> of <u>VANCLAU</u> (distance) (direction) (nearest town)	<u>Blue Clay</u>	<u>65'</u>	<u>169'</u>
WELL PURPOSE: <u>Home</u> (home, irrigation, municipal, industrial)	<u>Dray Coarse Sand</u>	<u>169'</u>	<u>176'</u>
WELL COMPLETION DATA: (1) diameter (inches) <u>2"</u>	<u>Blue Clay</u>	<u>176'</u>	<u>240'</u>
(2) total depth (feet) <u>283'</u>	<u>Dray Coarse Sand</u>	<u>240'</u>	<u>276'</u>
(3) static water level (feet) <u>124'</u> <u>below</u> top of ground.	<u>Dray Fine Sand</u>	<u>276'</u>	<u>283'</u>
(4) casing <u>PVC</u> , <u>273'</u> (material) (depth)	<u>10'-PVC Tail Pipe</u>		
<u>2"</u> (size) if telescope see back.			
(5) screen <u>10'</u> , <u>273'</u> (length) (depth to top)			
<u>2"</u> , <u>PVC</u> (size) (material)			
(6) pump <u>2</u> , <u>5</u> (HP) (yield gpm)			
<u>elec.</u> (type power)			
(7) electric log <u>no</u> (yes or no)			
<u></u> (organization running log)			
(8) how well bottom plugged <u>backwash valve</u>			

DEPT. OF NATURAL RESOURCES  
BUREAU OF LAND & WATER RESOURCES


APR 30 1984

RECEIVED

DRILLERS REMARKS:

If well telescopes please sketch and show depths.

GROUND LEVEL

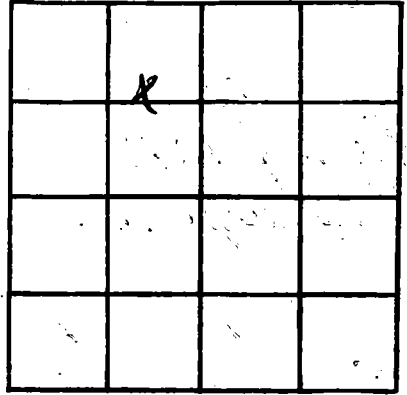

SECTION 23

Please indicate well location X.

ADDITIONAL INFORMATION

If more than one screen, show locations of each on sketch.