

MISSISSIPPI DEPARTMENT OF NATURAL RESOURCES

Bureau of Land and Water Resources

Southport Mall

P.O. Box 10631

Jackson, Mississippi 39209

WATER WELL DRILLERS LOG

Jackson
F 2069

8-20-84 19 Coast Water Well Sew. Jackson
date well completed firm name county well located

LANDOWNER: Larry Brown

description of formations encountered from to

Rt 2 - Box 232-B.

Top soil 0 5'

Ocean Springs, Miss.
(mailing address) 37564

Red Clay 5' 35'

WELL LOCATION:

Coarse sand 35' 67'

sec. 31 T. 5 S. R. 7 W.

Red Clay 67' 92'

4 miles NW of Vandeventer
(distance) (direction) (nearest town)

Coarse sand 92' 150'

WELL PURPOSE: None
(home, irrigation, municipal, industrial)

Blue Clay 150' 280'

WELL COMPLETION DATA:

fine sand 280' 293'

(1) diameter (inches) 2"

Med. sand 293' 320'

(2) total depth (feet) 320'

(3) static water level (feet) 100' below top of ground.

(4) casing PVC, 220'
(material) (depth)

5'-2" PVC Tail Pipe

2"
(size) If telescope see back.

(5) screen 10', 310'
(length) (depth to top)

2", PVC
(size) (material)

(6) pump 1 1/2 h.p., 6
(HP) (yield gpm)

Electric
(type power)

(7) electric log No
(yes or no)

(organization running log)


(8) how well bottom plugged Back wash valve

DRILLERS REMARKS:

DEPT. OF NATURAL RESOURCES
BUREAU OF LAND AND WATER RESOURCES
OCT 12 1984
RECEIVED

If well telescopes please sketch and show depths.

GROUND LEVEL

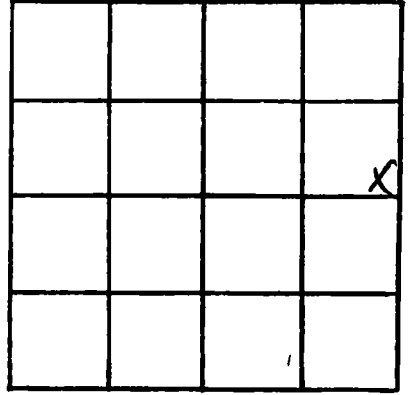

SECTION 31

Please indicate well location X.

ADDITIONAL INFORMATION

Lined area for additional information.

If more than one screen, show locations of each on sketch.