

MISSISSIPPI DEPARTMENT OF NATURAL RESOURCES

Bureau of Land and Water Resources

Southport Mall

P.O. Box 10631

Jackson, Mississippi 39209

WATER WELL DRILLERS LOG

Jackson
F 2070

8-28-84
date well completed

19 Coast Water Well Sew.
firm name

Jackson
county well located

LANDOWNER: James E. Hays

description of formations encountered

from to

2 - Gulchview Drive
Ocean Springs, Miss.
(mailing address) 37564

Top soil	0	3'
Red Clay	3	44'
Med. fine sand	44'	67'
Blue Clay	67'	115'
Med sand	115'	143'
Blue Clay	143'	225'
Med Coarse sand	225'	283'

WELL LOCATION:

sec 34 T 5 S R 7 E
2 miles N Vanlease
(distance) (direction) (nearest town)

WELL PURPOSE: Home
(home, irrigation, municipal, industrial)

WELL COMPLETION DATA:

(1) diameter (inches) 2"
(2) total depth (feet) 283'

(3) static water level (feet) 60' below top of ground

(4) casing PVC 273'
(material) (depth)

2" (size) If telescope see back.

(5) screen 10' 273'
(length) (depth to top)

2" PVC
(size) (material)

(6) pump 1/2 HP 6 1/2
(HP) (yield gpm)

Elect. (type power)

(7) electric log No.
(yes or no)

(organization running log)


(8) Is well bottom plugged
Cock Well Valve

DRILLERS REMARKS:

RECEIVED
OCT 19 1984
BUREAU OF LAND & WATER RESOURCES

If well telescopes please sketch and show depths.

GROUND LEVEL

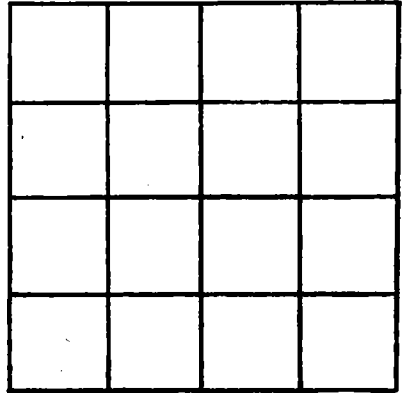

SECTION _____

Please indicate well location X.

ADDITIONAL INFORMATION

If more than one screen, show locations of each on sketch.