

MISSISSIPPI DEPARTMENT OF NATURAL RESOURCES

Bureau of Land and Water Resources

Southport Mall

P.O. Box 10631

Jackson, Mississippi 39209

WATER WELL DRILLERS LOG

F 2071
Jackson
10-19-84

19
10-20-84 date well completed

Jayfoyle firm name

JACKSON county well located

LANDOWNER: H. L. Hester
P.O. Box 537
Vicksburg MS 39567
(mailing address)

WELL LOCATION:
sec. 5 T. 5 N. R. 7 E.
0.4 miles (distance) of Vicksburg (direction) of (nearest town)

WELL PURPOSE:
(home irrigation, municipal, industrial)

WELL COMPLETION DATA:
(1) diameter (inches) 2"
(2) total depth (feet) 280
(3) static water level (feet) 70 below top of ground.
(4) casing PVC, 2.75' (material) (depth)
10 (size) if telescope see back.
(5) screen 5' #6 (length) (depth to top)
2' PVC (size) (material)
(6) pump 1 (HP) 10 (yield gpm)
Elet (type power)
(7) electric log no (yes or no)
no (organization running log)
(8) how well bottom plugged PVC Ball Check


description of formations encountered	from	to
Topsoil	0	10
Clay	10	20
Clay & Sand	20	40
Swampy Clay	40	60
Sand	60	120
Clay	120	125
Sand & Clay Strata	125	175
Fine Sand	175	240
Sand	240	280

DRILLERS REMARKS: Fair Well

1-15-85
JH

If well telescopes please sketch and show depths.

GROUND LEVEL

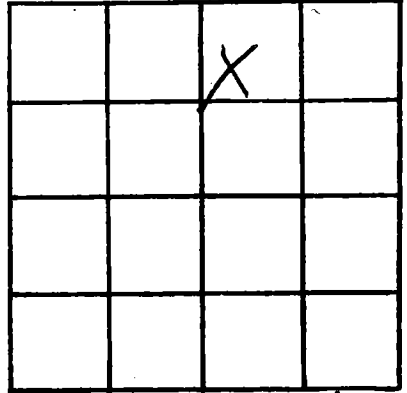

31 SECTION ~~2~~

Please indicate well location X.

ADDITIONAL INFORMATION

If more than one screen, show locations of each on sketch.