

MISSISSIPPI DEPARTMENT OF NATURAL RESOURCES

Bureau of Land and Water Resources

Southport Mall

P.O. Box 10631

Jackson, Mississippi 39209

WATER WELL DRILLERS LOG

Jackson  
F 2073

10-30-84  
date well completed

Coast Water Well Sew. Jackson  
firm name county well located

William Tillale  
LANDOWNER:

description of formations encountered

from to

17301 Old River Rd.

Top soil 0 2'

Clear Springs, Miss.  
(mailing address) 37564

Red Clay 2' 23'

WELL LOCATION:

Coarse sand 23' 68'

sec 23.5 T 5 S R 7 E W

Blue Clay 68' 250'

4 miles NE of VAN CLEAVE  
(distance) (direction) (nearest town)

Med. Coarse sand 250' 275'

WELL PURPOSE: None  
(home, irrigation, municipal, industrial)

left 2" Tail Pipe

WELL COMPLETION DATA:

- (1) diameter (inches) 2"
- (2) total depth (feet) 275'
- (3) static water level (feet) 110' below top of ground
- (4) casing PVC 265' (material), (depth)  
2" (size) if telescope see back.
- (5) screen 10' (length), 265' (depth to top)  
2" (size) PVC (material)
- (6) pump 2hp (HP), 8 (yield gpm)  
Elex (type power)
- (7) electric log No (yes or no)

(organization running log)


(8) back well bottom plugged with valve

f-285  
24W

DRILLERS REMARKS:

If well telescopes please sketch and show depths.

GROUND LEVEL

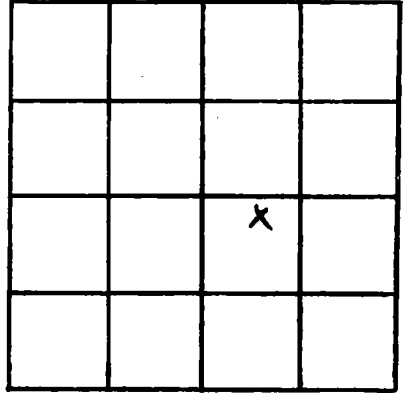

SECTION 23

Please indicate well location X.

ADDITIONAL INFORMATION

If more than one screen, show locations of each on sketch.