

MISSISSIPPI DEPARTMENT OF NATURAL RESOURCES

Bureau of Land and Water Resources

Southport Mall

P.O. Box 10631

Jackson, Mississippi 39209

WATER WELL DRILLERS LOG

F 2075
 JACKSON
 1-5-85

1-5-85 date well completed
 Coast Water Well Sew. firm name
 Jackson county well located

LANDOWNER: W.C. Busby, Jr.
Rt 2. Box 224
Ocean Springs, Miss
 (mailing address) 38564

description of formations encountered	from	to
Red Clay	0	10'
Blue Clay	10'	22'
White coarse sand	22'	45'
No Tail Pipe		

WELL LOCATION:
 sec. 18 T. 5 R. 7
6 miles NW of Pandora
 (distance) (direction) (nearest town)


WELL PURPOSE: Home
 (home, irrigation, municipal, industrial)

WELL COMPLETION DATA:

- (1) diameter (Inches) 2"
- (2) total depth (feet) 45'
- (3) static water level (feet) 15' below top of ground.
- (4) casing PVC, 35',
 (material) (depth)
2" if telescope see back.
 (size)
- (5) screen 10', 35'
 (length) (depth to top)
2", PVC
 (size) (material)
- (6) pump _____
 (HP) (yield gpm)
Electric
 (type power)
- (7) electric log No
 (yes or no)
- _____ (organization running log)

(8) How well bottom plugged?
Shut Wash Valve

DRILLERS REMARKS: _____

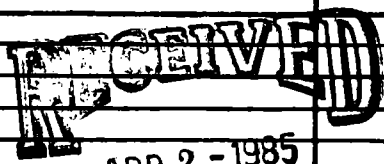

APR 2 - 1985

Department of Natural Resources
 Bureau of Land & Water Resources

If well telescopes please sketch and show depths.

GROUND LEVEL

			X

SECTION 18

Please indicate well location X.

ADDITIONAL INFORMATION

If more than one screen, show locations of each on sketch.