

MISSISSIPPI DEPARTMENT OF NATURAL RESOURCES

Bureau of Land and Water Resources

Southport Mall

P.O. Box 10631

Jackson, Mississippi 39209

WATER WELL DRILLERS LOG

JACKSON
F 2077

5-11-85
date well completed

Coast Water Well Sew. Jackson
firm name county well located

LANDOWNER: *Fabert Graham*
18501 Old River Rd.
Vanceburg, Miss.
(mailing address) *37564*

WELL LOCATION:
sec. *14* T. *5* S. R. *7* E
5 miles (distance) NE of VANCEBURG (direction) (nearest town)

WELL PURPOSE: *Home*
(home, irrigation, municipal, industrial)

WELL COMPLETION DATA:
(1) diameter (inches) *4"*
(2) total depth (feet) *280'*
(3) static water level (feet) *625'* below top of ground.
(4) casing *PVC*, *270'* (material) (depth)
4" (size) if telescope see back.
(5) screen *10'*, *270'* (length) (depth to top)
4" (size) *PVC* (material)
(6) pump *3 1/2 hp. Subm.*, *11* (HP) (yield gpm)
Electric (type power)
(7) electric log *No* (yes or no)
(organization running log)

(8) how well bottom plugged *Backwash valve*

DRILLERS REMARKS: *(blank)*

description of formations encountered	from	to
<i>Top soil</i>	<i>0</i>	<i>2'</i>
<i>Red Clay</i>	<i>3'</i>	<i>11'</i>
<i>Gray Clay</i>	<i>11'</i>	<i>30'</i>
<i>Red Med Sand</i>	<i>30'</i>	<i>43'</i>
<i>Red Clay & Striped Sand</i>	<i>43'</i>	<i>75'</i>
<i>Blue Clay</i>	<i>75'</i>	<i>190'</i>
<i>Gray Coarse sand</i>	<i>190'</i>	<i>200'</i>
<i>Red gravel</i>	<i>190'</i>	<i>200'</i>
<i>Blue Clay</i>	<i>200'</i>	<i>240'</i>
<i>Gray Coarse sand</i>	<i>240'</i>	<i>280'</i>


RECEIVED

JUL 10 1985

Department of Natural Resources
Bureau of Land & Water Resources

If well telescopes please sketch and show depths.

GROUND LEVEL

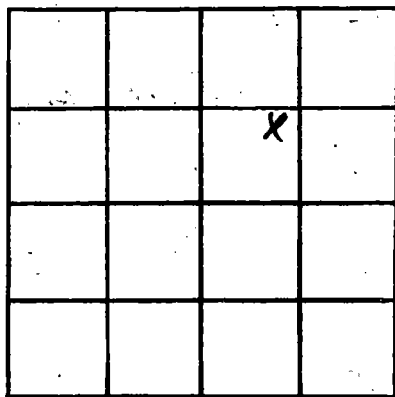

SECTION 14

Please indicate well location X.

ADDITIONAL INFORMATION

If more than one screen,
show locations of each on sketch.