

JACKSON

F2078

MISSISSIPPI DEPARTMENT OF NATURAL RESOURCES

Bureau of Land and Water Resources

Southport Mall

P.O. Box 10631

Jackson, Mississippi 39209

WATER WELL DRILLERS LOG

5-15-85
date well completed

Coast Water Well Sew.
firm name

Jackson
county well located

LANDOWNER:

Jack Carnley

Description of formations encountered

from to

5901 Waltman Rd

Top soil

0 3'

Ocean Springs, Miss.
(mailing address) 39564

Red Clay

3' 30'

WELL LOCATION:

sec. 20 T. 5 S. R. 7 E. NW
3 1/2 miles (distance) NW of VAN LEAVEN (direction) (nearest town)

Red Sand

30' 40'

Blue Clay

40' 70'

Coarse Sand

70' 120'

WELL PURPOSE:

Home (home, irrigation, municipal, industrial)

WELL COMPLETION DATA:

- (1) diameter (inches) 2"
- (2) total depth (feet) 120'
- (3) static water level (feet) 55' below top of ground.
- (4) casing PVC, 110' (material) (depth)
2" (size) if telescope see back.
- (5) screen 10' (length), 110' (depth to top)
2" (size), PVC (material)
- (6) pump 1/2 HP, 7 1/2 (yield gpm)
check (type power)
- (7) electric log No (yes or no)

(organization running log)

(8) how well bottom plugged? Backwash Valve


DRILLERS REMARKS:

RECEIVED
JUL 10 1985

Department of Natural Resources
Bureau of Land & Water Resources

If well telescopes please sketch and show depths.

GROUND LEVEL

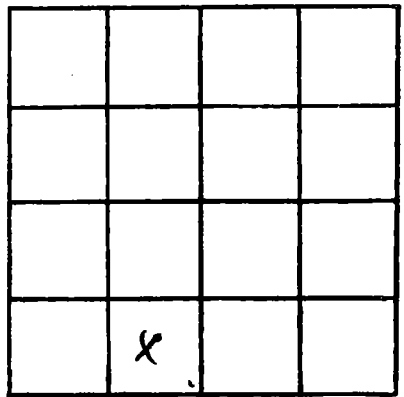

SECTION _____

Please indicate well location X.

ADDITIONAL INFORMATION

Lined area for additional information.

If more than one screen, show locations of each on sketch.