

MISSISSIPPI DEPARTMENT OF NATURAL RESOURCES

Bureau of Land and Water Resources

Southport Mall

P.O. Box 10631

Jackson, Mississippi 39209

WATER WELL DRILLERS LOG

Jackson
F2082

August 21, 85 19 Coast water well Jackson
date well completed firm name county well located

LANDOWNER: Michael Thrash
2113 Short Cut Rd.
Vandeventer Mo. 39564
(mailing address)

WELL LOCATION:
sec 3 / T 5 R 7
3 miles NW of Vandeventer
(distance) (direction) (nearest town)

WELL PURPOSE: home
(home, irrigation, municipal, industrial)

WELL COMPLETION DATA:
(1) diameter (inches) 2"
(2) total depth (feet) 330'
(3) static water level (feet) 105' below top of ground
(4) casing PVC, 313',
(material) (depth)
2" if telescope see back.
(size)
(5) screen 10', 313'
(length) (depth to top)
2", PVC
(size) (material)
(6) pump _____ (HP) _____ (yield gpm)

(type power)
(7) electric log no
(yes or no)

(organization running log)
(8) how well bottom plugged Backwash valve

| description of formations encountered | from | to |
|---------------------------------------|-------------|-------------|
| <u>Top soil</u> | <u>0'</u> | <u>1'</u> |
| <u>Red Clay</u> | <u>10'</u> | <u>30'</u> |
| <u>Red Coarse Sand</u> | <u>30'</u> | <u>58'</u> |
| <u>Red Clay</u> | <u>58'</u> | <u>85'</u> |
| <u>Red Coarse Sand</u> | <u>85'</u> | <u>157'</u> |
| <u>Yellow Clay</u> | <u>157'</u> | <u>165'</u> |
| <u>Blue Clay</u> | <u>165'</u> | <u>265'</u> |
| <u>Gray Coarse sand</u> | <u>265'</u> | <u>330'</u> |


RECEIVED
NOV - 4 1985

Department of Natural Resources
Bureau of Land & Water Resources

DRILLERS REMARKS:
7' 2" tail pipe

If well telescopes please sketch and show depths.

GROUND LEVEL

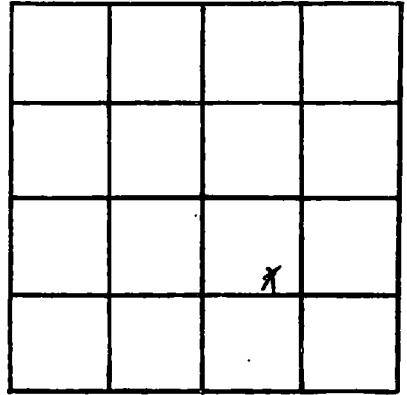

SECTION 31

Please indicate well location X.

ADDITIONAL INFORMATION

If more than one screen,
show locations of each on sketch.