

MISSISSIPPI DEPARTMENT OF NATURAL RESOURCES

Bureau of Land and Water Resources

Southport Mall

P.O. Box 10631

Jackson, Mississippi 39209

WATER WELL DRILLERS LOG

August 16, 85, 1985, Coastwater well Jackson
 date well completed firm name county well located

LANDOWNER: James Hurton

description of formations encountered

from to

Vanclave, No 351st

Red Clay 0' 15'

(mailing address)

Red fine sand 15' 19'

WELL LOCATION:

sec. 23 T. 5 N. R. 7 W.
4 miles N of Vanclave
 (distance) (direction) (nearest town)

Red clay 19' 25'

Red fine sand 25' 60'

WELL PURPOSE: Home
 (home, irrigation, municipal, industrial)

Red. Coarse sand 60' 75'

WELL COMPLETION DATA:

Blue Clay 75' 105'

(1) diameter (inches) 2"

Blue Clay & streaks of fine clay sand 105' 150'

(2) total depth (feet) 315'

(3) static water level (feet) 115' below top of ground.

Blue Clay 150' 270'

(4) casing PVC 300'
 (material) (depth)

Gray. Coarse sand 270' 310'

2" If telescope see back.
 (size)

Blue Clay 310' 315'

(5) screen 10' 300'
 (length) (depth to top)

2" PVC
 (size) (material)

(6) pump 2hp 6
 (HP) (yield gpm)

Elect.
 (type power)

(7) electric log no
 (yes or no)

(organization running log)

(8) how well bottom plugged Backwash valve

DRILLERS REMARKS:


5' - 2" tail pipe

RECEIVED
 NOV - 1 1985

Department of Natural Resources
 Bureau of Land & Water Resources

If well telescopes please sketch and show depths.

GROUND LEVEL

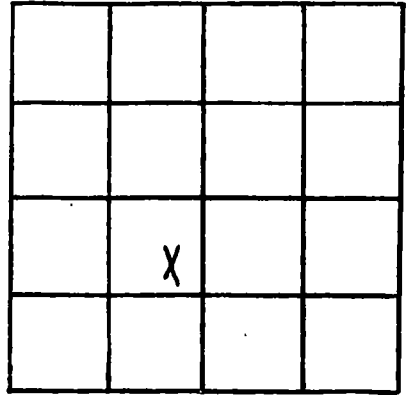

SECTION 23

Please indicate well location X.

ADDITIONAL INFORMATION

If more than one screen, show locations of each on sketch.