

MISSISSIPPI DEPARTMENT OF NATURAL RESOURCES

Bureau of Land and Water Resources

Southport Mall

P.O. Box 10631

Jackson, Mississippi 39209

WATER WELL DRILLERS LOG

JACKSON
F 2090

11-25-85 19 Coastal Water Well Sew. Jackson
date well completed firm name county well located

LANDOWNER: Wayne Wilcox
2709 Goff Rd.
Varclave, Ms. 39564
(mailing address)

WELL LOCATION:
sec. 26 T. 5 S. R. 7 E.
4 miles NE of Varclave
(distance) (direction) (nearest town)

WELL PURPOSE: home
(home, irrigation, municipal, industrial)

WELL COMPLETION DATA:

- (1) diameter (inches) 2"
- (2) total depth (feet) 344'
- (3) static water level (feet) 109' ^{below} top of ground.
- (4) casing PVC, 329',
(material) (depth)
2" if telescope see back.
(size)
- (5) screen 10', 329'
(length) (depth to top)
2", PVC
(size) (material)
- (6) pump 2HP, 7
(HP) (yield gpm)
Elect
(type power)
- (7) electric log No
(yes or no)
- (organization running log)
- (8) how well bottom plugged
Back wash valve

description of formations encountered	from	to
<u>Top soil</u>	<u>0</u>	<u>3'</u>
<u>Red Clay</u>	<u>3'</u>	<u>40'</u>
<u>Red Coarse sand</u>	<u>40'</u>	<u>65'</u>
<u>Blue Clay & streak off sand</u>	<u>65'</u>	<u>93'</u>
<u>Blue Clay</u>	<u>93'</u>	<u>256'</u>
<u>Gray fine sand</u>	<u>256'</u>	<u>277'</u>
<u>Gray med sand</u>	<u>277'</u>	<u>300'</u>
<u>Gray Coarse sand</u>	<u>300'</u>	<u>339'</u>
<u>Blue Clay</u>	<u>339'</u>	<u>344'</u>

RECEIVED


JAN 03 1986

Department of Natural Resources
Bureau of Land & Water Resources

DRILLERS REMARKS:
5' - 2" PVC Tail Pipe
Shut Catcher

If well telescopes please sketch and show depths.

GROUND LEVEL

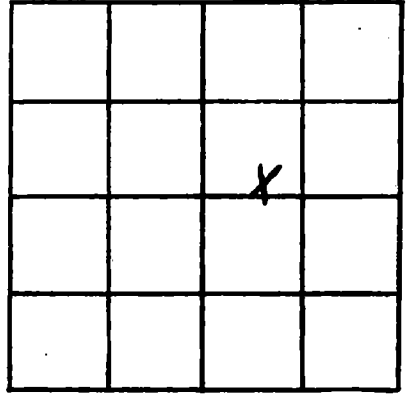

SECTION 26

Please indicate well location X.

ADDITIONAL INFORMATION

If more than one screen, show locations of each on sketch.