

MISSISSIPPI DEPARTMENT OF NATURAL RESOURCES

Bureau of Land and Water Resources

Southport Mall

P.O. Box 10631

Jackson, Mississippi 39209

WATER WELL DRILLERS LOG

COASTAL DRILLING & SERVICE CO.

Jackson  
F 2092

8/24/85 19\_\_  
date well completed

RT. 11, BOX #1  
name

Jackson  
county well located

BILOXI, MS 39532

LANDOWNER: Terry W. VanCleave

description of formations encountered	from	to
top soil	1	3
sea sand	3	20
red clay	20	85
grey + bleed clay	85	200
hard bleed clay	200	255
fine water sand	255	265
good water sand	265	275

VanCleave - Carwash

VanCleave, MS  
(mailing address)

WELL LOCATION:

sec. 9 T. 5 N. R. 7 E. W  
VanCleave  
(distance) miles (direction) of (nearest town)

WELL PURPOSE: home  
(home, irrigation, municipal, industrial)

WELL COMPLETION DATA:

- (1) diameter (inches) 4" x 2"
- (2) total depth (feet) 20 275 hole
- (3) static water level (feet) 20 below top of ground. 275 above
- (4) casing PVC, 255, (material) (depth) 275 well
- 4" x 2" (size) If telescope see back.
- (5) screen 10, 250 (length) (depth to top) PVC, PVC (size) (material)
- (6) pump 1 1/2, 11 (HP) (yield gpm) ETC (type power)
- (7) electric log NO (yes or no)

(organization running log)

(8) how well bottom plugged 2" DRUCK  
wash valve

DRILLERS REMARKS:

**RECEIVED**


**FEB 24 1986**

Department of Natural Resources  
Bureau of Land & Water Resources

If well telescopes please sketch and show depths.

GROUND LEVEL

190' 4" PVC casing

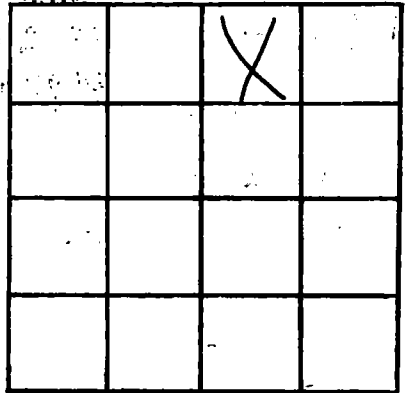

SECTION \_\_\_\_\_

Please indicate well location X.

ADDITIONAL INFORMATION

85' 2" PVC casing

10' 2" PVC screen

2" BACK wash valve

If more than one screen, show locations of each on sketch.