

MISSISSIPPI DEPARTMENT OF NATURAL RESOURCES

Bureau of Land and Water Resources

Southport Mall

P.O. Box 10631

Jackson, Mississippi 39209

WATER WELL DRILLERS LOG

Jackson  
F2093

1-16-86 date well completed 19 Coals water well firm name Jackson county well located

LANDOWNER: Carl Hoving  
17701 Old River Rd  
Ocean Springs MS  
(mailing address)

WELL LOCATION:  
sec 23 T 5 R 7  
4 1/2 miles N/E of Vandave  
(distance) (direction) (nearest town)

WELL PURPOSE: home  
(home, irrigation, municipal, industrial)

- WELL COMPLETION DATA:
- (1) diameter (inches) 2"
  - (2) total depth (feet) 210'
  - (3) static water level (feet) 107' below top of ground
  - (4) casing PVC 195' (material) (depth)  
2" (size) if telescope see back.
  - (5) screen 10' 195' (length) (depth to top)  
2" (size) PVC (material)
  - (6) pump 2 HP 20 GPM 3 (HP) (yield gpm)  
Elex (type power)
  - (7) electric log no (yes or no)  
(organization running log)
  - (8) has well bottom plugged Backflow valve

| description of formations encountered | from | to  |
|---------------------------------------|------|-----|
| top soil                              | 0    | 2   |
| Red clay                              | 2    | 15  |
| white coarse sand                     | 15   | 60  |
| white coarse sand w/ streak of clay   | 60   | 70  |
| Blue clay                             | 70   | 190 |
| Gray med sand                         | 190  | 205 |
| Blue clay                             | 205  | 210 |


RECEIVED  
MAR 6 1986

Department of Natural Resources  
Bureau of Land & Water Resources

DRILLERS REMARKS:  
5ft 2" PVC tail pipe

If well telescopes please sketch and show depths.

GROUND LEVEL

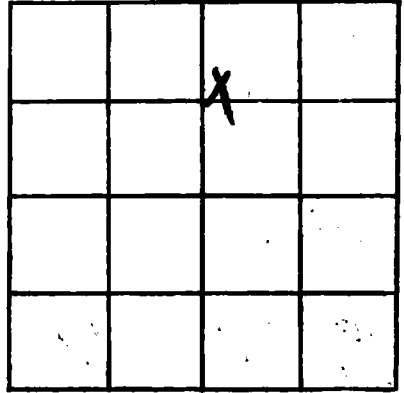

SECTION 23

Please indicate well location X.

ADDITIONAL INFORMATION

If more than one screen, show locations of each on sketch.