

MISSISSIPPI DEPARTMENT OF NATURAL RESOURCES

Bureau of Land and Water Resources

Southport Mall

P.O. Box 10631

Jackson, Mississippi 39209

WATER WELL DRILLERS LOG

Jackson
F2099
~~_____~~
~~_____~~

Jackson

1/31/86

COASTAL DRILLING & SERVICE CO.

~~HARRISON~~

date well completed

RT. 11, BOX 8T

county well located

LANDOWNER: Donna K. PROXI, JR. 39532

Description of formations encountered	from	to
top soil	1	3
red clay	3	85
soft blue clay	85	210
hard blue clay	210	400
fine water sand	400	420
good water sand	420	430

Daisy Vester

Biloxi, ms

(mailing address)

WELL LOCATION:

sec 27 T 6 N R 7 E S W

Daisy Vester

(distance) (direction) (nearest town)

WELL PURPOSE: home

(home, irrigation, municipal, industrial)

WELL COMPLETION DATA:

- (1) diameter (Inches) 2
- (2) total depth (feet) 430
- (3) static water level (feet) 10 below top of ground

- (4) casing PVC, 430 (material) (depth)

(size) if telescope see back.

- (5) screen 10, 420 (length) (depth to top)

2" PVC (size) (material)


- (6) pump 1, 10 (HP) (yield gpm)

elec. (type power)

- (7) electric log no (yes or no)

(organization running log)

- (8) how well bottom plugged 2" back wash valve

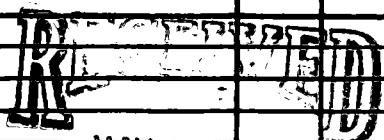


MAY 7 9 1986

DRILLERS REMARKS:

Department of Natural Resources
Bureau of Land & Water Resources

If well telescopes please sketch and show depths.

GROUND LEVEL

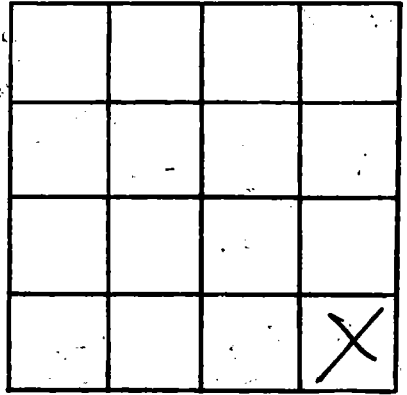

SECTION _____

Please indicate well location X.

ADDITIONAL INFORMATION

If more than one screen, show locations of each on sketch.