

MISSISSIPPI DEPARTMENT OF NATURAL RESOURCES
Bureau of Land and Water Resources
 Southport Mall
 P.O. Box 10631
 Jackson, Mississippi 39209
WATER WELL DRILLERS LOG

JACKSON
F2096

1-19-86
 date well completed

FRYFOGIE WELL SERV
 firm name

JACKSON
 county well located

LANDOWNER: JEFFERY McMillian

Vanclave, MS 39564
 (mailing address)

WELL LOCATION:

sec. 5 T. 5 N. R. 7 E.
2 1/2 miles East of Vanclave
 (distance) (direction) (nearest town)

WELL PURPOSE: dom
 (home, irrigation, municipal, industrial)

WELL COMPLETION DATA:

- (1) diameter (inches) 2"
- (2) total depth (feet) 465'
- (3) static water level (feet) 20' ^{below} above top of ground.
- (4) casing PVC 455'
 (material) (depth)
hy if telescope see back.
 (size)
- (5) screen 10' 455'
 (length) (depth to top)
2' PVC
 (size) (material)
- (6) pump 1 15
 (HP) (yield gpm)
Elect
 (type power)
- (7) electric log no
 (yes or no)
no
 (organization running log)
- (8) how well bottom plugged PVC
Ball Check

description of formations encountered	from	to
Top Soil	0	70
Sand	10	20
Clay	20	40
St. Sand	40	42
Clay	42	62
Sandy Clay	62	80
Sand	80	120
Clay	120	140
HT	140	240
Fine Sand	240	250
Sand	250	270
Clay	270	330
Fine Sand	330	440
Med Blue Sand	440	465


RECEIVED
 MART 9 1986

DRILLERS REMARKS:

Department of Natural Resources
 Bureau of Land & Water Resources

If well telescopes please sketch and show depths.

GROUND LEVEL

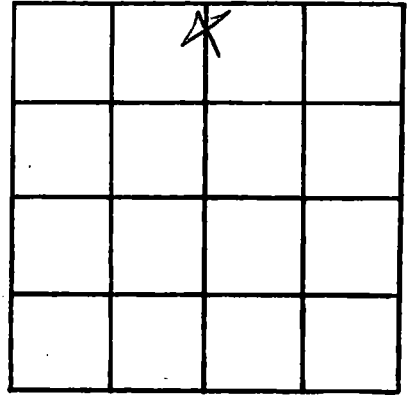

SECTION 1

Please indicate well location X.

ADDITIONAL INFORMATION

If more than one screen, show locations of each on sketch.