

MISSISSIPPI DEPARTMENT OF NATURAL RESOURCES

Bureau of Land and Water Resources

Southport Mall

P.O. Box 10631

Jackson, Mississippi 39209

WATER WELL DRILLERS LOG

JACKSON
 F 9098
 ✓

4-5-86 date well completed
 19 Coast water well firm name
 Jackson county well located

LANDOWNER: Edgar McChon
15124 Old Linn Rd Loop
Vanderlane, Ms 39564
 (mailing address)

description of formations encountered	from	to
top soil	0	2
Red Clay	2	8
White Coastal Sand	8	17
Red Clay	17	20

WELL LOCATION:
 sec. 4 T. 5 N. R. 7 W.
4 miles NE of Vanderlane
 (distance) (direction) (nearest town)

White Coastal Sand	20	40
--------------------	----	----

WELL PURPOSE: home
 (home, irrigation, municipal, industrial)

Blue Clay	40	135
-----------	----	-----

WELL COMPLETION DATA:

- (1) diameter (inches) 2"
- (2) total depth (feet) 235'
- (3) static water level (feet) 75 ^{below} above top of ground.
- (4) casing PVC, 220'
 (material) (depth)
2"
 (size) If telescope see back.
- (5) screen 10', 220'
 (length) (depth to top)
2", PVC
 (size) (material)
- (6) pump 1/2 HP, 5
 (HP) (yield gpm)
Chas.
 (type power)
- (7) electric log no
 (yes or no)

 (organization running log)
- (8) how well bottom plugged backwash valve

Blue Clay w/ streaks of sand	135	150
------------------------------	-----	-----

Blue Clay	150	180
-----------	-----	-----

med. sand	180	183
-----------	-----	-----

Blue Clay	183	208
-----------	-----	-----

med. Gray sand	208	230
----------------	-----	-----

Blue Clay	230	235
-----------	-----	-----


235 - 220 = 15
 15 - 10 = 5
 225 - 220 = 5

RECEIVED
 MAY 12 1996

DRILLERS REMARKS:
5 ft 2" PVC tail pipe

If well telescopes please sketch and show depths.

GROUND LEVEL

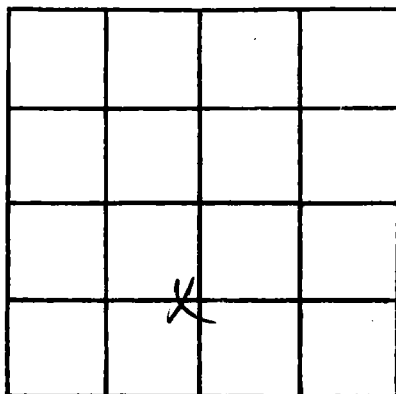

SECTION 41

Please indicate well location X.

ADDITIONAL INFORMATION

If more than one screen, show locations of each on sketch.