

MISSISSIPPI DEPARTMENT OF NATURAL RESOURCES

Bureau of Land and Water Resources

Southport Mall

P.O. Box 10631

Jackson, Mississippi 39209

WATER WELL DRILLERS LOG

COASTAL DRILLING & SERVICE CO.

Jackson

RI. 111, BOX 81

county well located

JACKSON
F2100

4/18/86 19

LANDOWNER: J. Spence

Lake O Pine

Vanceleave, ms
(mailing address)

description of formations encountered

from

to

top soil	1	3
red clay	3	25
hard blue clay	25	160
soft blue clay	160	210
good water sand	210	290

WELL LOCATION:

sec. 9 T. 5 N. R. 7 E. W. 5
Vanceleave
(distance) miles (direction) of (nearest town)

WELL PURPOSE: home
(home, irrigation, municipal, industrial)

WELL COMPLETION DATA:

- (1) diameter (inches) 4" x 2"
- (2) total depth (feet) 290'
- (3) static water level (feet) 15' below above top of ground.
- (4) casing PVC, 275', 4" x 2" (material) (depth) (size) if telescope see back.
- (5) screen 15', 275', 2' (length) (depth to top) (size) (material)
- (6) pump 1 HP, 10 (HP) (yield gpm) Elc. (type power)
- (7) electric log No (yes or no)
(organization running log)
- (8) how well bottom plugged 2" back wash valve

RECEIVED

JUN 19 1986

Department of Natural Resources
Bureau of Land and Water Resources

DRILLERS REMARKS:

If well telescopes please sketch and show depths.

GROUND LEVEL


160' 4" pvc casing

130' 2" pvc casing

15' 2" pvc screen

2" BACK wash valve

If more than one screen, show locations of each on sketch.

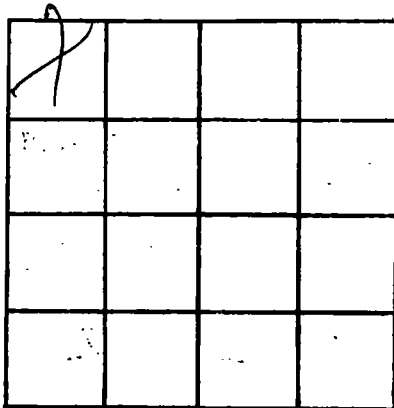

SECTION _____

Please indicate well location X.

ADDITIONAL INFORMATION

Multiple horizontal lines for additional information.