

JACKSON
F 2101

MISSISSIPPI
BOARD OF WATER COMMISSIONERS
416 North State Street
Jackson, Mississippi 39201

WATER WELL DRILLERS LOG

5-26-1986 date well completed St. Pierre firm name Wilkey Co. county well located Jackson

LANDOWNER: Billy M. Self
22532 Old River Rd.
Van Cleave, Ms
(mailing address)

description of formations encountered	from	to
<u>top soil</u>	<u>0</u>	<u>15</u>
<u>clay</u>	<u>15</u>	<u>30</u>
<u>good sand</u>	<u>30</u>	<u>65</u>
<u>clay</u>	<u>65</u>	<u>200</u>
<u>good sand</u>	<u>200</u>	<u>230</u>

WELL LOCATION:
sec. 2 T 5 N R 7 E
12 miles West of Furley
(distance) (direction) (nearest town)

WELL PURPOSE:
(home, irrigation, municipal, industrial)

WELL COMPLETION DATA:

(1) diameter (inches) 2"

(2) total depth (feet) 230'

(3) static water level (feet) 120' below above top of ground.

(4) casing plastic 2 1/2"
(material) (depth)

0 If telescope see back.
(size)

(5) screen 10', 230'
(length) (depth to top)

006 plastic
(size) (material)

(6) pump 2 6
(HP) (yield gpm)

electric
(type power)

(7) electric log yes or (no)
(organization running log)

(8) how well bottom plugged BLW

RECEIVED


AUG 11 1986

DRILLERS REMARKS:

Department of Natural Resources
Bureau of Land & Water Resources

If well telescopes please sketch and show depths.

GROUND LEVEL

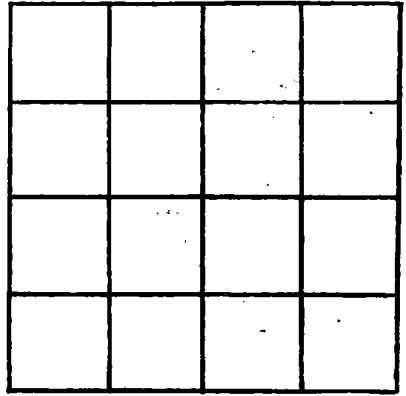

SECTION _____

Please indicate well location X.

ADDITIONAL INFORMATION

If more than one screen, show locations of each on sketch.