

MISSISSIPPI DEPARTMENT OF NATURAL RESOURCES

Bureau of Land and Water Resources

Southport Mall

P.O. Box 10631

Jackson, Mississippi 39209

WATER WELL DRILLERS LOG

JACKSON  
F 2102

8-1-86 19 Coast Waterwell Jackson  
date well completed firm name county well located

LANDOWNER: Frank Smit  
16401 Lake Drive E  
Wandlerville ms  
(mailing address)

description of formations encountered	from	to
Top Soil	0	1
Red Sand	1	3
Red Clay	3	28
White Coarse Sand	28	107
Pea Gravel	107	120
Blue Clay	120	220
Med Gray Sand	220	255
Coarse Sand	255	275
Blue Clay	275	280

WELL LOCATION:  
sec. 28 T 5 N R 7 E  
3 1/2 miles NW of VANCREATE  
(distance) (direction) (nearest town)

WELL PURPOSE: HOME  
(home, irrigation, municipal, industrial)

- WELL COMPLETION DATA:
- (1) diameter (inches) 2"
  - (2) total depth (feet) 280 ft
  - (3) static water level (feet) 61 below above top of ground.
  - (4) casing PVC, 265',  
(material) (depth)  
2"  
(size) if telescope see back.
  - (5) screen 10', 265'  
(length) (depth to top)  
2" PVC  
(size) (material)
  - (6) pump                        
(HP) (yield gpm)  
            
(type power)
  - (7) electric log NO  
(yes or no)  
            
(organization running log)
  - (8) how well bottom plugged backwash valve


DRILLERS REMARKS:  
5 ft 2" PVC tail pipe

RECEIVED  
SEP 11 1986

Department of Natural Resources  
Bureau of Land & Water Resources

If well telescopes please sketch and show depths.

GROUND LEVEL

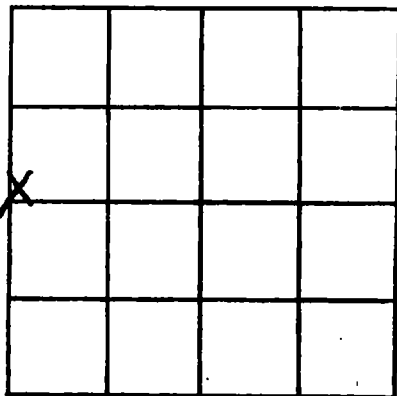

SECTION 28

Please indicate well location X.

ADDITIONAL INFORMATION

If more than one screen,  
show locations of each on sketch.