

MISSISSIPPI DEPARTMENT OF NATURAL RESOURCES  
 Bureau of Land and Water Resources  
 Southport Mall  
 P.O. Box 10631  
 Jackson, Mississippi 39209  
**WATER WELL DRILLERS LOG**

JACKSON  
F 2103

8-3-86 19 Coastwater well JACKSON  
 date well completed firm name county well located

LANDOWNER:	Description of formations encountered	from	to
<u>Ernest Auer</u>	<u>Top soil</u>	<u>0</u>	<u>2</u>
<u>18001 Hwy 57</u>	<u>Red Clay</u>	<u>2</u>	<u>19</u>
<u>Vanceleve mn</u>	<u>Red coarse sand</u>	<u>19</u>	<u>72</u>
(mailing address) <u>39564</u>	<u>Blue Clay</u>	<u>72</u>	<u>118</u>
WELL LOCATION:	<u>Red coarse sand</u>	<u>118</u>	<u>154</u>
sec. <u>18</u> T <u>5</u> N R <u>7</u> E	<u>Blue Clay</u>	<u>154</u>	<u>201</u>
<u>6</u> miles <u>Nw</u> of <u>VANCELEVE</u>	<u>Blue Clay +</u>	<u>201</u>	<u>495</u>
(distance) (direction) (nearest town)	<u>Cyster Shell</u>		
WELL PURPOSE: <u>Home</u>	<u>Blue Clay</u>	<u>495</u>	<u>520</u>
(home, irrigation, municipal, industrial)	<u>Blue Clay +</u>	<u>520</u>	<u>535</u>
WELL COMPLETION DATA:	<u>Streak of Sand</u>		
(1) diameter (inches) <u>4 1/2</u>	<u>Blue Clay</u>	<u>535</u>	<u>695</u>
(2) total depth (feet) <u>835'</u>	<u>Blue Clay +</u>	<u>695</u>	<u>710</u>
(3) static water level (feet) <u>90</u> <sup>below</sup> <u>200</u> <sup>above</sup> top of ground.	<u>Streak of Sand</u>		
(4) casing <u>PVC</u> <u>810'</u> (material) (depth)	<u>Blue Clay</u>	<u>710</u>	<u>804</u>
<u>4"</u> (size) If telescope see back. <u>8 3/8"</u>	<u>Gray coarse</u>	<u>804</u>	<u>834</u>
(5) screen <u>20'</u> <u>810'</u> (length) (depth to top)	<u>Sand + Gravel</u>		
<u>2"</u> (size) <u>PVC</u> (material)	<u>Blue Clay</u>	<u>835</u>	
(6) pump <u>1hp</u> <u>25</u> (HP) (yield gpm)			
<u>elect.</u> (type power)			
(7) electric log <u>no</u> (yes or no)			
(organization running log)			
(8) how well bottom plugged <u>backwash valve</u>			



DRILLERS REMARKS:  
5 ft. 2" PVC tail pipe

Department of Natural Resources  
 Bureau of Land & Water Resources

RECEIVED  
 SEP 11 1986

If well telescopes please sketch and show depths.

GROUND LEVEL

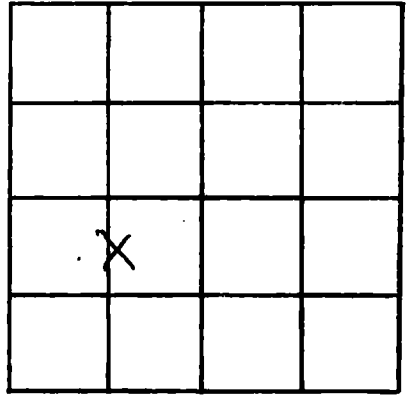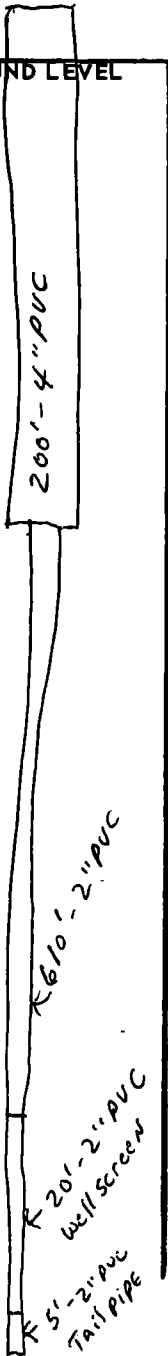

SECTION 18

Please indicate well location X.

ADDITIONAL INFORMATION

If more than one screen, show locations of each on sketch.