

MISSISSIPPI DEPARTMENT OF NATURAL RESOURCES

Bureau of Land and Water Resources

Southport Mall

P.O. Box 10631

Jackson, Mississippi 39209

WATER WELL DRILLERS LOG

Jackson  
F2104

8-8-86 19 Coast water well Jackson  
date well completed firm name county well located

LANDOWNER: Glenn Davis  
3408 Gerry Davis Rd.  
Pascagoula, ms. 39567  
(mailing address)

WELL LOCATION:  
sec. 30 T. 5 N. R. 7 E.  
4 1/2 miles NW of VINCENT  
(distance) (direction) (nearest town)

WELL PURPOSE: HOME  
(home, irrigation, municipal, industrial)

WELL COMPLETION DATA:

- (1) diameter (inches) 2"
- (2) total depth (feet) 295' Hole
- (3) static water level (feet) 106' below top of ground
- (4) casing PVC, 280' (material) (depth)  
2' (size) If telescope see back.
- (5) screen 10' , 280' (length) (depth to top)  
2" PVC (size) (material)
- (6) pump 2 (HP) 8 (yield gpm)  
ELECT (type power) 280/10  
with 240'
- (7) electric log NO (yes or no) with 240'
- (organization running log)
- (8) how well bottom plugged  
nickel wire mesh

description of formations encountered	from	to
Top soil	0	2
Red Clay	2	19
Red Clay + streak of sand	19	45
Blue Clay	45	81
Red med. sand.	81	100
Blue Clay w/ streak of sand	100	110
Red coarse sand	110	138
Blue Clay	138	172
Blue fine sand	172	189
Blue Clay	189	260
Gray coarse sand	260	290
Gray coarse sand + wood	290	293
Blue Clay	293	295

RECEIVED


SEP 11 1986

DRILLERS REMARKS:  
5 ft 2" PVC tailpipe

Department of Natural Resources  
Bureau of Land & Water Resources

If well telescopes please sketch and show depths.

GROUND LEVEL

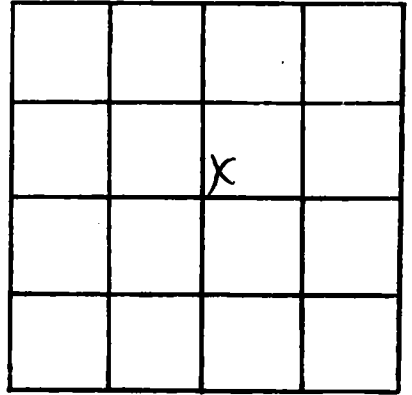

SECTION 30

Please indicate well location X.

ADDITIONAL INFORMATION

If more than one screen, show locations of each on sketch.