

826-4113

MISSISSIPPI DEPARTMENT OF NATURAL RESOURCES
Bureau of Land and Water Resources

COUNTY WELL LOCATED
Jackson

WELL NUMBER CODED
F 2108

DATE WELL COMPLETED
11-14-80

PERMIT NUMBER

NAME OF DRILLING FIRM
Coast Waterwell

P.O. Box 10631
Jackson, Mississippi 39209
WATER WELL DRILLERS LOG

NAME & MAILING ADDRESS OF LANDOWNER
**Dean Parrell
Waltman Rd,
Vancleave Ms**

WELL LOCATION: SEC TOWNSHIP RANGE
20 5 N 7 E

DISTANCE DIRECTION NEAREST TOWN
4 1/2 Miles N. of VANCELEAVE

OTHER LANDMARK

WELL PURPOSE: Home, Irrigation, Municipal, Industrial, Fish Pond, etc.
home

PUMP DATA

PUMP TYPE (Circle One):
Submersible, Turbine, **Jet** Flowing Well,
Other (Describe) _____

POWER TYPE (Circle One):
Electric, Tractor, Diesel, Gasoline, Butane,
Other (Describe) _____

Pump Capacity (GPM) No. of Stages Setting Depth
6 3 FT.

PUMP TEST

Well yielded _____ GPM with
a drawdown of _____ ft.
after _____ hours of pumping

WELL DATA

Well Depth 227	Casing Diameter (In.) 2"	Casing Length (Ft.) 212'
Type of Casing PUC	Hole Depth 227	Depth to Static Water Level 115'

TYPE OF COMPLETION: (Circle One or More):
Gravel Packed Underreamed, Telescoped,
Natural Development Open Hole, Other
(Describe) _____

Top of Lap Pipe or Reduction in Casing
FEET IF TELESCOPED OR MORE THAN ONE SCREEN: USE BACK PAGE

LOG DATA

TYPE OF LOG RUN (Circle One):
Electric, Gamma Ray, Density, Sonic, **No Log Run**, Neutron,
Other (Describe) _____

Name of Organization Running Log

SCREEN DATA

Diameter - Inches 2"	Length - Feet 10'	Slot Size - Inches .008
Screen Type PUC	Depth to Bottom - Feet 227'	

GEOLOGIC DATA (Office Use Only)

Surface Elev.	Geologic Unit	Unit Thickness	Depth to Top
Subs. SWL	Date	Analysis	Aquifer Test

Driller's Remarks

DESCRIPTION OF FORMATIONS ENCOUNTERED	FROM	TO
Top Soil	0	1
Brown Clay	1	43
Streaks of sand	-	-
Blue Clay	43	80
Red med sand	80	120
Blue Clay	120	214
Gray med sand	214	227

RECEIVED


MAY 21 1987

Department of Natural Resources
Bureau of Land & Water Resources

IF MORE SPACE IS NEEDED, USE BACK

If well telescopes please sketch and show depths.

GROUND LEVEL

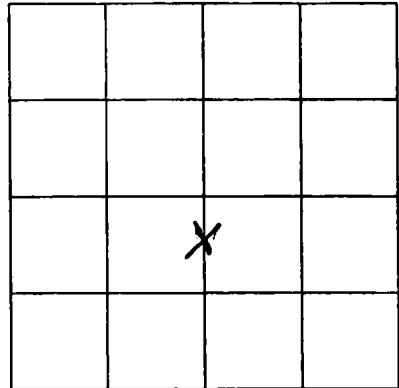

SECTION 20

Please indicate well location X.

ADDITIONAL INFORMATION

If more than one screen,
show location of each on sketch.