

MISSISSIPPI DEPARTMENT OF NATURAL RESOURCES
Bureau of Land and Water Resources

P.O. Box 10631
Jackson, Mississippi 39209
WATER WELL DRILLERS LOG

COUNTY WELL LOCATED Jackson	
WELL NUMBER F2113	CODED
DATE WELL COMPLETED 12-17-86	

PERMIT NUMBER
NAME OF DRILLING FIRM Coast Waterwell

NAME & MAILING ADDRESS OF LANDOWNER Frontier Homes LAKE - O - PINES DR. VAN CLEAVE MS.		
WELL LOCATION: SEC	TOWNSHIP	RANGE
	5 S	7 W
DISTANCE 4 Miles	DIRECTION N	NEAREST TOWN VAN CLEAVE
OTHER LANDMARK		
WELL PURPOSE: Home, Irrigation, Municipal, Industrial, Fish Pond, etc. home		

PUMP DATA		
PUMP TYPE (Circle One): Submersible, Turbine, Jet Flowing Well, Other (Describe) _____		
POWER TYPE (Circle One): Electric, Tractor, Diesel, Gasoline, Butane, Other (Describe) _____		
Pump Capacity (GPM) 9	No. of Stages 3	Setting Depth FT.
PUMP TEST		
Well yielded _____ GPM with a drawdown of _____ ft. after _____ hours of pumping		

WELL DATA		
Well Depth 270 1/2	Casing Diameter (In.) 2"	Casing Length (Ft.) 255'
Type of Casing PVC	Hole Depth 270'	Depth to Static Water Level 75'
TYPE OF COMPLETION: (Circle One or More): Natural Development , Gravel Packed, Underreamed, Telescoped, Open Hole, Other		
Top of Lap Pipe or Reduction in Casing FEET IF TELESCOPED OR MORE THAN ONE SCREEN: USE BACK PAGE		

LOG DATA	
TYPE OF LOG RUN (Circle One): Electric, Gamma Ray, Density, Sonic, No Log Run , Other (Describe) _____	
Name of Organization Running Log	

SCREEN DATA		
Diameter - Inches 2"	Length - Feet 10'	Slot Size - Inches .008
Screen Type PVC	Depth to Bottom - Feet 265'	

GEOLOGIC DATA (Office Use Only)			
Surface Elev.	Geologic Unit	Unit Thickness	Depth to Top
Subs. SWL	Date	Analysis	Aquifer Test
Driller's Remarks			


RECEIVED

DESCRIPTION OF FORMATIONS ENCOUNTERED	FROM	TO	FORMATIONS (Continued)	FROM	TO
Top Soil	0	1	MAY 21 1987 Department of Natural Resources Bureau of Land & Water Resources		
White Coarse Sand	1	3			
Red Clay	3	44			
White Coarse Sand	44	106			
Blue Clay	106	230			
Gray Coarse Sand	230	265			
Pea Gravel	265	270			

IF MORE SPACE IS NEEDED, USE BACK

If well telescopes please sketch and show depths.

GROUND LEVEL

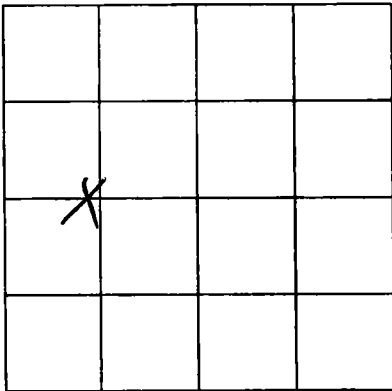

SECTION 28

Please indicate well location X.

ADDITIONAL INFORMATION

If more than one screen,
show location of each on sketch.