

JACKSON  
F 2116

MISSISSIPPI DEPARTMENT OF NATURAL RESOURCES  
Bureau of Land and Water Resources  
Southport Mall  
P.O. Box 10631  
Jackson, Mississippi 39209  
WATER WELL DRILLERS LOG

11-14 1986 date well completed  
Pierce Drilling Co. firm name  
Jackson county well located

LANDOWNER: Susan Bell

| description of formations encountered | from     | to  |
|---------------------------------------|----------|-----|
|                                       | top soil | 0   |
| clay                                  | 10       | 30  |
| good sand                             | 30       | 90  |
| clay                                  | 90       | 245 |
| good sand                             | 245      | 258 |

Oceans Springs, Ms (mailing address)

WELL LOCATION:  
sec. 33 T. 5 N R. 7 E  
2 miles North of Vicksburg (distance) (direction) (nearest town)

WELL PURPOSE:  
(home, irrigation, municipal, industrial)


WELL COMPLETION DATA:

- (1) diameter (inches) 2"
- (2) total depth (feet) 258'
- (3) static water level (feet) 70' below above top of ground.
- (4) casing plastic, 253' (material) (depth)
- (5) screen 5' (length), 258' (depth to top)
- (6) pump 006 plastic (size) (material), 8 (HP) (yield gpm)
- (7) electric log (yes or no) electric (type power)

(organization running log)

(8) how well bottom plugged BW


DRILLERS REMARKS:

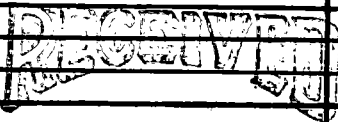

Department of Natural Resources  
Bureau of Land & Water Resources

If well telescopes please sketch and show depths.

GROUND LEVEL

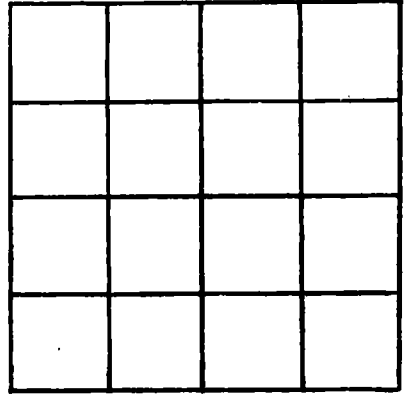

SECTION \_\_\_\_\_

Please indicate well location X.

ADDITIONAL INFORMATION

If more than one screen, show locations of each on sketch.