

10c - pump
MISSISSIPPI DEPARTMENT OF NATURAL RESOURCES
Bureau of Land and Water Resources

P.O. Box 10631
Jackson, Mississippi 39209
WATER WELL DRILLERS LOG

COUNTY WELL LOCATED <i>Jackson</i>	
WELL NUMBER <i>F 8191</i>	CODED
DATE WELL COMPLETED <i>8-24-87</i>	

PERMIT NUMBER
NAME OF DRILLING FIRM <i>Coast Water Well Serv.</i>

NAME & MAILING ADDRESS OF LANDOWNER <i>Leonard Ware Breland Road Vandœuvre, Ms. 39564</i>			
WELL LOCATION:	SEC	TOWNSHIP	RANGE
	<i>33</i>	<i>5</i>	<i>7</i>
DISTANCE	DIRECTION	NEAREST TOWN	
<i>2</i> Miles	<i>NW</i>	<i>Vandœuvre</i>	
OTHER LANDMARK			
WELL PURPOSE: Home, Irrigation, Municipal, Industrial, Fish Pond, etc. <i>Home</i>			

PUMP DATA		
PUMP TYPE (Circle One): Submersible, Turbine, <u>Jet</u> Flowing Well, Other (Describe)		
POWER TYPE (Circle One): <u>Electric</u> , Tractor, Diesel, Gasoline, Butane, Other (Describe)		
Pump Capacity (GPM)	No. of Stages	Setting Depth FT.
PUMP TEST		
Well yielded _____ GPM with a drawdown of _____ ft. after _____ hours of pumping		

WELL DATA		
Well Depth <i>90' 85'</i>	Casing Diameter (In.) <i>2"</i>	Casing Length (Ft.) <i>75'</i>
Type of Casing <i>PVC</i>	Hole Depth <i>90'</i>	Depth to Static Water Level <i>25'</i>
TYPE OF COMPLETION: (Circle One or More): <u>Gravel Packed</u> , Underreamed, Telescoped, <u>Natural Development</u> , Open Hole, Other (Describe)		
Top of Lap Pipe or Reduction in Casing FEET IF TELESCOPED OR MORE THAN ONE SCREEN: USE BACK PAGE		

LOG DATA	
TYPE OF LOG RUN (Circle One): Electric, Gamma Ray, Density, Sonic, Neutron, Other (Describe) <u>No Log Run</u>	
Name of Organization Running Log	

SCREEN DATA		
Diameter - Inches <i>2</i>	Length - Feet <i>10'</i>	Slot Size - Inches <i>.008</i>
Screen Type <i>PVC</i>	Depth to Bottom - Feet <i>85'</i>	

GEOLOGIC DATA (Office Use Only)			
Surface Elev.	Geologic Unit	Unit Thickness	Depth to Top
Subs. SWL	Date	Analysis	Aquifer Test



DESCRIPTION OF FORMATIONS ENCOUNTERED	FROM	TO	FORMATIONS (Continued)	FROM	TO
			<i>SEP 21 1987</i>		
<i>Top Soil</i>	<i>0</i>	<i>2</i>	Department of Natural Resources Bureau of Land & Water Resources		
<i>Brown Clay</i>	<i>2</i>	<i>31</i>			
<i>Brown Lane Sand</i>	<i>31</i>	<i>88</i>			
<i>Blue Clay</i>	<i>88</i>	<i>90</i>			
			IF MORE SPACE IS NEEDED, USE BACK		

If well telescopes please sketch and show depths.


GROUND LEVEL

λ			

SECTION 33

Please indicate well location X.

ADDITIONAL INFORMATION

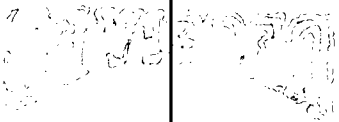

If more than one screen, show location of each on sketch.