

JACKSON  
F 2123

MISSISSIPPI DEPARTMENT OF NATURAL RESOURCES  
Bureau of Land and Water Resources  
Southport Mall  
P.O. Box 10631  
Jackson, Mississippi 39209  
**WATER WELL DRILLERS LOG**

5-6 1987 Peace Drilling Co. Jackson  
date well completed firm name county well located

LANDOWNER: David Christ Co.  
Vandœuvre, Ms  
(mailing address)  
WELL LOCATION:  
sec. 29 T-5 N R-7 E  
4 miles North of Vandœuvre  
(distance) (direction) (nearest town)

description of formations encountered	from	to
<u>Top soil</u>	<u>0</u>	<u>10</u>
<u>Clay</u>	<u>10</u>	<u>25</u>
<u>Sand + Clay</u>	<u>25</u>	<u>55</u>
<u>good Sand</u>	<u>55</u>	<u>105</u>

WELL PURPOSE:  
(home) Irrigation, municipal, Industrial

WELL COMPLETION DATA:  
(1) diameter (inches) 2"  
(2) total depth (feet) 105'  
(3) static water level (feet) 30' below above top of ground.  
(4) casing plastic, 100'  
(material) (depth)  
0 if telescope see back.  
(size)  
(5) screen 5', 105'  
(length) (depth to top)  
006, plastic  
(size) (material)  
(6) pump 1 12  
(HP) (yield gpm)  
electric  
(type power)  
(7) electric log yes or no  
(organization running log)  
(8) how well bottom plugged BW

RECEIVED


SEP 15 2007

Department of Natural Resources  
Bureau of Land & Water Resources

DRILLERS REMARKS:

If well telescopes please sketch and show depths.

GROUND LEVEL

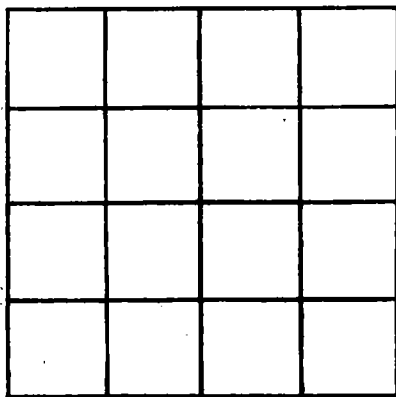

SECTION \_\_\_\_\_

Please indicate well location X.

ADDITIONAL INFORMATION

If more than one screen, show locations of each on sketch.