

MISSISSIPPI DEPARTMENT OF NATURAL RESOURCES

Bureau of Land and Water Resources

Southport Mall

P.O. Box 10631

Jackson, Mississippi 39209

WATER WELL DRILLERS LOG

Jackson
F 224

3-18-87 date well completed
Pierce Drilling Co firm name
Jackson county well located

LANDOWNER: <u>Ronald Goetzak</u>	description of formations encountered	from	to
<u>Vanclave, Ms</u> (mailing address)	<u>Top Soil</u>	<u>0</u>	<u>10</u>
WELL LOCATION: sec. <u>35</u> T- <u>5</u> N R- <u>7</u> E <u>3</u> miles <u>East</u> of <u>Vanclave</u> (distance) (direction) (nearest town)	<u>Clay</u>	<u>10</u>	<u>30</u>
WELL PURPOSE: <u>(home)</u> Irrigation, municipal, industrial	<u>good Sand</u>	<u>30</u>	<u>55</u>
WELL COMPLETION DATA: (1) diameter (inches) <u>2"</u> (2) total depth (feet) <u>55'</u> (3) static water level (feet) <u>30'</u> <u>below</u> above top of ground. (4) casing <u>plastic, 50'</u> (material) (depth) <u>0</u> If telescope see back. (size) (5) screen <u>5'</u> , <u>55'</u> (length) (depth to top) <u>006, plastic</u> (size) (material) (6) pump <u>2</u> <u>12</u> (HP) (yield gpm) <u>electric</u> (type power) (7) electric log <u>(yes or no)</u> (organization running log) (8) how well bottom plugged <u>BeW</u>			
DRILLERS REMARKS:			


RECEIVED

SEP 15 1987

Department of Natural Resources
Bureau of Land & Water Resources

If well telescopes please
sketch and show depths.

GROUND LEVEL

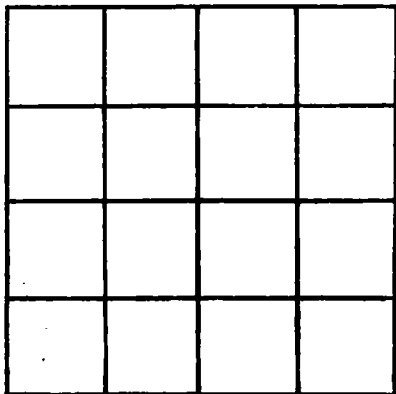

SECTION _____

Please indicate well location X.

ADDITIONAL INFORMATION

If more than one screen,
show locations of each on sketch.