

MISSISSIPPI DEPARTMENT OF NATURAL RESOURCES
Bureau of Land and Water Resources

P.O. Box 10631
Jackson, Mississippi 39209
WATER WELL DRILLERS LOG

COUNTY WELL LOCATED <i>Jackson</i>	
WELL NUMBER <i>F 432</i>	CODED
DATE WELL COMPLETED <i>6-10-88</i>	

PERMIT NUMBER
NAME OF DRILLING FIRM <i>Pierce Drilling</i>

NAME & MAILING ADDRESS OF LANDOWNER <i>Ronald Wattman</i> <i>Hwy 57</i> <i>Unclau, Ms</i>			
WELL LOCATION: SEC	TOWNSHIP	RANGE	
<i>20</i>	<i>5</i>	<i>N 7</i>	<i>W</i>
DISTANCE	DIRECTION	NEAREST TOWN	
<i>4</i> Miles	<i>North</i>	<i>of Unclau</i>	
OTHER LANDMARK			
WELL PURPOSE: <input checked="" type="checkbox"/> Home, <input type="checkbox"/> Irrigation, <input type="checkbox"/> Municipal, <input type="checkbox"/> Industrial, <input type="checkbox"/> Fish Pond, etc.			

PUMP DATA		
PUMP TYPE (Circle One): Submersible, Turbine, <input checked="" type="radio"/> Jet, Flowing Well, Other (Describe) _____		
POWER TYPE (Circle One): <input checked="" type="radio"/> Electric, Tractor, Diesel, Gasoline, Butane, Other (Describe) _____		
Pump Capacity (GPM) <i>10</i>	No. of Stages <i>2</i>	Setting Depth <i>75'</i> FT.
PUMP TEST		
Well yielded <i>10</i> GPM with a drawdown of <i>5'</i> ft. after <i>1</i> hours of pumping		

WELL DATA		
Well Depth <i>127'</i>	Casing Diameter (In.) <i>2"</i>	Casing Length (Ft.) <i>117</i>
Type of Casing <i>Plastic</i>	Hole Depth <i>127'</i>	Depth to Static Water Level <i>20'</i>
TYPE OF COMPLETION: (Circle One or More): <input type="checkbox"/> Gravel Packed, <input type="checkbox"/> Underreamed, <input type="checkbox"/> Telescoped, <input checked="" type="checkbox"/> Natural Development, <input type="checkbox"/> Open Hole, <input type="checkbox"/> Other		
Top of Lap Pipe or Reduction in Casing		
FEET		
IF TELESCOPED OR MORE THAN ONE SCREEN: USE BACK PAGE		

LOG DATA	
TYPE OF LOG RUN (Circle One): Electric, Gamma Ray, Density, Sonic, <input checked="" type="radio"/> No Log Run, Neutron, Other (Describe) _____	
Name of Organization Running Log	

SCREEN DATA		
Diameter - Inches <i>2"</i>	Length - Feet <i>10'</i>	Slot Size - Inches <i>006</i>
Screen Type <i>Plastic</i>	Depth to Bottom - Feet <i>127'</i>	

GEOLOGIC DATA (Office Use Only)			
Surface Elev.	Geologic Unit	Unit Thickness	Depth to Top
Subs. SWL	Date	Analysis	Aquifer Test
Driller's Remarks			


DESCRIPTION OF FORMATIONS ENCOUNTERED	FROM	TO
<i>Top soil</i>	<i>0</i>	<i>10</i>
<i>Sand & Clay</i>	<i>10</i>	<i>25</i>
<i>Clay</i>	<i>25</i>	<i>50</i>
<i>Sand & Clay</i>	<i>50</i>	<i>75</i>
<i>good sand</i>	<i>75</i>	<i>127</i>

FORMATIONS ENCOUNTERED	FROM	TO
RECEIVED		
<i>JUN 28 1988</i>		
Department of Natural Resources Bureau of Land & Water Resources		

IF MORE SPACE IS NEEDED, USE BACK

If well telescopes please sketch and show depths.

GROUND LEVEL

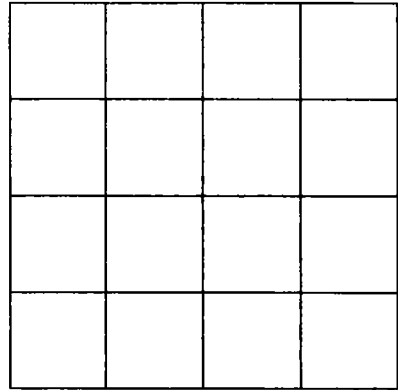

SECTION _____

Please indicate well location X.

ADDITIONAL INFORMATION

If more than one screen,
show location of each on sketch.