

MISSISSIPPI DEPARTMENT OF NATURAL RESOURCES

Bureau of Land and Water Resources

P.O. Box 10631

Jackson, Mississippi 39209

WATER WELL DRILLERS LOG

COUNTY WELL LOCATED Jackson	
WELL NUMBER F2137	CODED
DATE WELL COMPLETED 7-28-88	

PERMIT NUMBER
NAME OF DRILLING FIRM Coast Water Well Service

NAME & MAILING ADDRESS OF LANDOWNER Betty Grakam			
18501 Old River Rd			
Vandœuvre Ms			
WELL LOCATION: SEC	TOWNSHIP	RANGE	
14	5	N	7
		S	W
DISTANCE	DIRECTION	NEAREST TOWN	
6 Miles	NE	Vandœuvre	
OTHER LANDMARK			
WELL PURPOSE: Home, Irrigation, Municipal, Industrial, Fish Pond, etc. home			

PUMP DATA		
PUMP TYPE (Circle One): Submersible, Turbine, Jet, Flowing Well, Other (Describe)		
POWER TYPE (Circle One): Electric, Tractor, Diesel, Gasoline, Butane, Other (Describe)		
Pump Capacity (GPM)	No. of Stages	Setting Depth
		101 FT.
PUMP TEST		
Well yielded _____ GPM with a drawdown of _____ ft. after _____ hours of pumping		

WELL DATA		
Well Depth 280'	Casing Diameter (In.) 4"	Casing Length (Ft.) 255'
Type of Casing PVC	Hole Depth 280'	Depth to Static Water Level 125'
TYPE OF COMPLETION: (Circle One or More): Gravel Packed, Underreamed, Telescoped, Natural Development , Open Hole, Other (Describe)		
Top of Lap Pipe or Reduction in Casing		
FEET		
IF TELESCOPED OR MORE THAN ONE SCREEN: USE BACK PAGE		

LOG DATA	
TYPE OF LOG RUN (Circle One): Electric, Gamma Ray, Density, Sonic, No Log Run , Neutron, Other (Describe)	
Name of Organization Running Log	

SCREEN DATA		
Diameter - Inches 2"	Length - Feet 20'	Slot Size - Inches .008
Screen Type PVC	Depth to Bottom - Feet 275'	

GEOLOGIC DATA (Office Use Only)			
Surface Elev.	Geologic Unit	Unit Thickness	Depth to Top
Subs. SWL	Date	Analysis	Aquifer Test

Driller's Remarks

RECEIVED

DESCRIPTION OF FORMATIONS ENCOUNTERED	FROM	TO	FORMATIONS (Continued)	
			FROM	TO
Top soil	0	2		
Red Clay	2	7		
Blue Clay	7	25		
White Coarse Sand	25	70		
Blue Clay	70	180		
Gray Coarse Sand	180	192		
Blue Clay	192	240		
Gray Coarse sand	240	275		
Blue Clay	275	280		


NOV 15 1988

**Department of Natural Resources
Bureau of Land & Water Resources**

IF MORE SPACE IS NEEDED, USE BACK

If well telescopes please sketch and show depths.

GROUND LEVEL

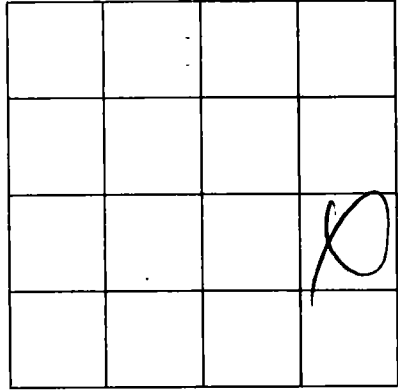

SECTION

14

Please indicate well location X.

ADDITIONAL INFORMATION

If more than one screen,
show location of each on sketch.