

MISSISSIPPI DEPARTMENT OF NATURAL RESOURCES
Bureau of Land and Water Resources

P.O. Box 10631
Jackson, Mississippi 39209
WATER WELL DRILLERS LOG

COUNTY WELL LOCATED <i>Jackson</i>	
WELL NUMBER <i>FA72</i>	CODED
DATE WELL COMPLETED <i>8-3-90</i>	

PERMIT NUMBER
NAME OF DRILLING FIRM <i>Coast Water Well, Ser. Inc.</i>

NAME & MAILING ADDRESS OF LANDOWNER <i>Cheryl Whittle</i> <i>Chick-A-Cre Circle</i> <i>Vandeventer, Mo</i>		
WELL LOCATION: SEC <i>33</i>	TOWNSHIP <i>5</i>	RANGE <i>7</i> <i>W</i>
DISTANCE <i>2</i> Miles	DIRECTION <i>N</i>	NEAREST TOWN of <i>Vandeventer</i>
OTHER LANDMARK		
WELL PURPOSE Home Irrigation, Municipal, Industrial, Fish Pond, etc.		

PUMP DATA		
PUMP TYPE (Circle One): Submersible, Turbine, <u><i>Jet</i></u> Flowing Well, Other (Describe) _____		
POWER TYPE (Circle One): <u><i>Electric</i></u> Tractor, Diesel, Gasoline, Butane, Other (Describe) _____ H/P <u><i>1</i></u>		
Pump Capacity (GPM) <i>9</i>	No. of Stages <i>2</i>	Setting Depth _____ FT.
PUMP TEST		
Well yielded _____ GPM with a drawdown of _____ ft. after _____ hours of pumping		

WELL DATA		
Well Depth <i>1005</i>	Casing Diameter (In.) <i>20</i>	Casing Length (Fl.) <i>95'</i>
Type of Casing <i>PVC</i>	Hole Depth <i>105'</i>	Depth to Static Water Level <i>40'</i>
TYPE OF COMPLETION: (Circle One or More): <u><i>Natural Development</i></u> , Gravel Packed, Underreamed, Telescoped, Open Hole, Other		
Top of Lap Pipe or Reduction in Casing _____ FEET		
IF TELESCOPED OR MORE THAN ONE SCREEN: USE BACK PAGE		

LOG DATA	
TYPE OF LOG RUN (Circle One): Electric, Gamma Ray, Density, Sonic, Neutron, Other (Describe) _____ <u><i>No Log Run</i></u>	
Name of Organization Running Log	

SCREEN DATA		
Diameter - Inches <i>24</i>	Length - Feet <i>10'</i>	Slot Size - Inches <i>1008</i>
Screen Type <i>PVC</i>	Depth to Bottom - Feet <i>1005'</i>	


GEOLOGIC DATA (Office Use Only)			
Surface Elev.	Geologic Unit	Unit Thickness	Depth to Top
Subs. SWL	Date	Analysis	Aquifer Test
Driller's Remarks			

DESCRIPTION OF FORMATIONS ENCOUNTERED	FROM	TO	FORMATIONS (Continued)	FROM	TO
<i>Top soil</i>	<i>0</i>	<i>2</i>	<div style="font-size: 2em; font-weight: bold; opacity: 0.5;">RECEIVED</div> <p>OCT 15 1990</p> <p>Department of Natural Resources Bureau of Land & Water Resources</p>		
<i>Yellow Clay</i>	<i>2</i>	<i>12</i>			
<i>Coarse sand</i>	<i>12</i>	<i>20</i>			
<i>Red Clay</i>	<i>20</i>	<i>45</i>			
<i>med. coarse sand</i>	<i>45</i>	<i>105</i>			

IF MORE SPACE IS NEEDED, USE BACK

If well telescopes please sketch and show depths.

GROUND LEVEL

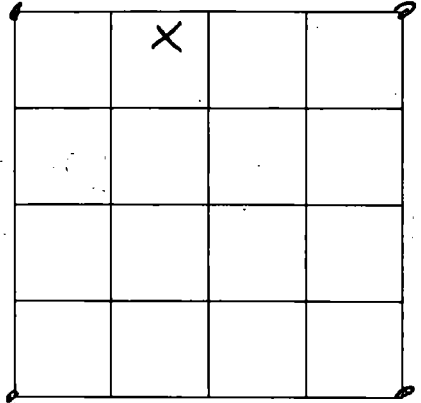

SECTION 33

Please indicate well location X.

ADDITIONAL INFORMATION

Lined area for additional information.

If more than one screen, show location of each on sketch.