

MISSISSIPPI DEPARTMENT OF NATURAL RESOURCES

Bureau of Land and Water Resources

Southport Mall

P.O. Box 10631

Jackson, Mississippi 39209

WATER WELL DRILLERS LOG

JACKSON
F 2180

7-25

19 89

Steincke & Son

Jackson

date well completed

firm name

county well located

LANDOWNER: Mr. Major Jones

description of formations encountered

from

to

Top soil

0'

2'

Red clay

2'

15'

Blue clay

15'

45'

Sand

45'

70'

(mailing address)

WELL LOCATION:

sec. 33 T. 36 N. R. 2 E. 5 miles S of Vardele
(distance) (direction) (nearest town)

WELL PURPOSE: Home
(home, irrigation, municipal, industrial)


WELL COMPLETION DATA:

- (1) diameter (inches) 2"
- (2) total depth (feet) 70'
- (3) static water level (feet) 45' below above top of ground.
- (4) casing PVC (15' (material) (depth)
- (size) If telescope see back.
- (5) screen 5' (65' (length) (depth to top)
- 2" (PVC (size) (material)
- (6) pump 1 (7 (HP) (yield gpm)
- SREPA (type power)
- (7) electric log NO (yes or no)

(organization running log)

(8) how well bottom plugged PVC, Wash valve


DRILLERS REMARKS:

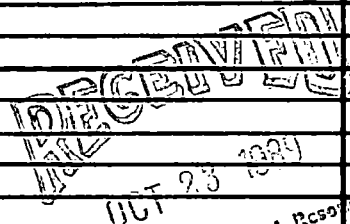

Department of Natural Resources
Bureau of Land & Water Resources

If well telescopes please sketch and show depths.

GROUND LEVEL

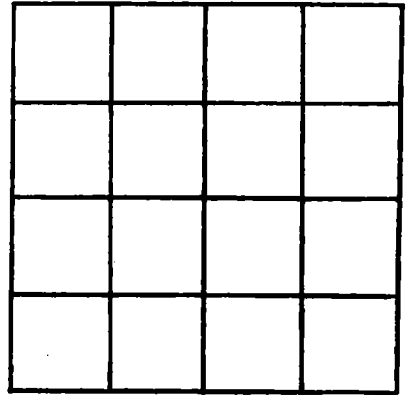

SECTION _____

Please indicate well location X.

ADDITIONAL INFORMATION

If more than one screen, show locations of each on sketch.