

MISSISSIPPI DEPARTMENT OF ENVIRONMENTAL QUALITY
Bureau of Land and Water Resources

COUNTY WELL LOCATED
Jackson

WELL NUMBER
F 2085

CODED

DATE WELL COMPLETED
2-18-92

PERMIT NUMBER

NAME OF DRILLING FIRM
Coast Water Well Ser Inc.

P. O. Box 10631
Jackson, MS 39289-0631
WATER WELL DRILLERS LOG

NAME & MAILING ADDRESS OF LANDOWNER
Lloyd Overstreet

WELL LOCATION: SEC *33* TOWNSHIP *55* RANGE *7*
771 *S* *7* *W*

DISTANCE *6* Miles DIRECTION *north* NEAREST TOWN *Unchase*

OTHER LANDMARK

WELL PURPOSE Home Irrigation, Municipal, Industrial, Fish Pond, etc.

PUMP DATA

PUMP TYPE (Circle One):
Submersible, Turbine, Jet, Flowing Well,
Other (Describe)

POWER TYPE (Circle One):
Electric, Tractor, Diesel, Gasoline, Butane,
Other (Describe) H/P

Pump Capacity (GPM) No. of Stages Setting Depth FT.

PUMP TEST
Well yielded _____ GPM with
a drawdown of _____ ft.
after _____ hours of pumping

WELL DATA

Well Depth <i>195'</i>	Casing Diameter (In.) <i>2"</i>	Casing Length (Ft.) <i>181'</i>
Type of Casing <i>PVC</i>	Hole Depth <i>195'</i>	Depth to Static Water Level <i>102"</i>

TYPE OF COMPLETION: (Circle One or More):
Gravel Packed, Underreamed, Telescoped,
Natural Development, Open Hole, Other
(Describe)

Top of Lap Pipe or Reduction in Casing
FEET IF TELESCOPED OR MORE THAN ONE SCREEN: USE BACK PAGE

LOG DATA

TYPE OF LOG RUN (Circle One):
Electric, Gamma Ray, Density, Sonic, Neutron,
Other (Describe) *No Log Run.*

Name of Organization Running Log

SCREEN DATA

Diameter - Inches <i>2"</i>	Length - Feet <i>10'</i>	Slot Size - Inches <i>0.08</i>
Screen Type <i>PVC</i>	Depth to Bottom - Feet <i>198'</i>	

GEOLOGIC DATA (Office Use Only)

Surface Elev.	Geologic Unit	Unit Thickness	Depth to Top
Subs. SWL	Date	Analysis	Aquifer Test

Driller's Remarks

DESCRIPTION OF FORMATIONS ENCOUNTERED	FROM	TO	FORMATION	TO
<i>top soil</i>	<i>0</i>	<i>2</i>		
<i>Red Clay</i>	<i>2</i>	<i>15</i>		
<i>med. sand</i>	<i>15</i>	<i>35</i>		
<i>Blue Clay</i>	<i>35</i>	<i>130</i>		
<i>med. sand</i>	<i>130</i>	<i>148</i>		
<i>Blue Clay</i>	<i>148</i>	<i>165</i>		
<i>med. to coarse sand</i>	<i>165</i>	<i>191</i>		
<i>Blue Clay</i>	<i>191</i>	<i>195</i>		

RECEIVED


MAR 23 1992

Dept. of Environmental Quality
Bureau of Land & Water Resources

IF MORE SPACE IS NEEDED, USE BACK

If well telescopes please sketch and show depths.

GROUND LEVEL

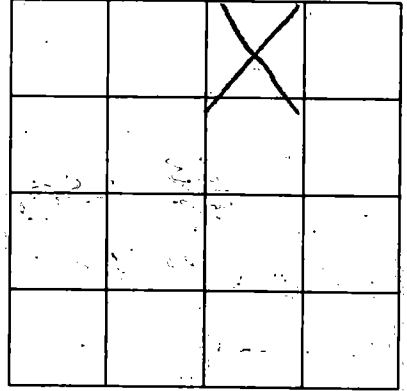

SECTION _____

Please indicate well location X.

ADDITIONAL INFORMATION

Lined area for additional information.

RECEIVED

1987

U.S. DEPARTMENT OF THE INTERIOR
BUREAU OF LAND MANAGEMENT

If more than one screen, show location of each on sketch.