

MISSISSIPPI DEPARTMENT OF ENVIRONMENTAL QUALITY
Bureau of Land and Water Resources

P. O. Box 10631
Jackson, MS 39289-0631
WATER WELL DRILLERS LOG

COUNTY WELL LOCATED <i>Jackson</i>
WELL NUMBER <i>F2213</i>
DATE WELL COMPLETED <i>8-28-92</i>

PERMIT NUMBER
NAME OF DRILLING FIRM <i>Coast Water Well, Inc.</i>

NAME & MAILING ADDRESS OF LANDOWNER <i>Sonny Fletcher</i>		
WELL LOCATION: SEC <u>26</u> TOWNSHIP <u>5^N</u> RANGE <u>7^E</u>		
DISTANCE <u>4</u> Miles	DIRECTION <u>NE</u>	NEAREST TOWN <u>Wendover</u>
OTHER LANDMARK		
WELL PURPOSE: <u>Home Irrigation</u> , Municipal, Industrial, Fish Pond, etc.		

PUMP DATA		
PUMP TYPE (Circle One): <u>Submersible</u> , Turbine, Jet, Flowing Well, Other (Describe) _____		
POWER TYPE (Circle One): <u>Electric</u> , Tractor, Diesel, Gasoline, Butane, Other (Describe) _____ H/P <u>✓</u>		
Pump Capacity (GPM) <u>19</u>	No. of Stages	Setting Depth _____ FT.
PUMP TEST Well yielded _____ GPM with a drawdown of _____ ft. after _____ hours of pumping		

WELL DATA		
Well Depth <u>298'</u>	Casing Diameter (In.) <u>2"</u>	Casing Length (Ft.) <u>278'</u>
Type of Casing <u>PVC</u>	Hole Depth <u>291'</u>	Depth to Static Water Level <u>115'</u>
TYPE OF COMPLETION: (Circle One or More): <u>Natural Development</u> , Underreamed, Telescoped, Gravel Packed, Open Hole, Other		
Top of Lap Pipe or Reduction in Casing _____ FEET IF TELESCOPED OR MORE THAN ONE SCREEN: USE BACK PAGE		

LOG DATA	
TYPE OF LOG RUN (Circle One): <u>No Log Run</u> , Electric, Gamma Ray, Density, Sonic, Neutron, Other (Describe) _____	
Name of Organization Running Log	

SCREEN DATA		
Diameter - Inches <u>2"</u>	Length - Feet <u>10'</u>	Slot Size - Inches <u>.008</u>
Screen Type <u>PVC</u>	Depth to Bottom - Feet <u>288'</u>	


GEOLOGIC DATA (Office Use Only)			
Surface Elev.	Geologic Unit	Unit Thickness	Depth to Top
Subs. SWL	Date	Analysis	Aquifer Test
Driller's Remarks			

DESCRIPTION OF FORMATIONS ENCOUNTERED	FROM	TO
<i>top soil</i>	<i>0</i>	<i>2</i>
<i>Red Clay</i>	<i>2</i>	<i>22</i>
<i>med. red sand</i>	<i>22</i>	<i>45</i>
<i>Blue Clay w/ sand</i>	<i>45</i>	<i>198</i>
<i>Coars. sand</i>	<i>198</i>	<i>196</i>
<i>Blue Clay w/ sand</i>	<i>196</i>	<i>250</i>
<i>med. sand</i>	<i>250</i>	<i>291</i>

FORMATIONS (Continued)	
RECEIVED	
OCT 07 1992	
Dept. of Environmental Quality Bureau of Land & Water Resources	
IF MORE SPACE IS NEEDED, USE BACK	

If well telescopes please sketch and show depths.

GROUND LEVEL

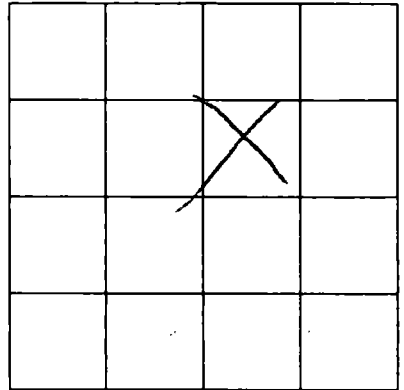

SECTION _____

Please indicate well location X:

ADDITIONAL INFORMATION

WATER

WATER

If more than one screen,
show location of each on sketch.