

**MISSISSIPPI DEPARTMENT OF ENVIRONMENTAL QUALITY**  
Bureau of Land and Water Resources

P. O. Box 10631  
Jackson, MS 39289-0631  
**WATER WELL DRILLERS LOG**

COUNTY WELL LOCATED <i>Jackson</i>	
WELL NUMBER <i>F2214</i>	CODED
DATE WELL COMPLETED <i>5-15-92</i>	

PERMIT NUMBER
NAME OF DRILLING FIRM <i>Coast Water Well Dr. Inc.</i>

NAME & MAILING ADDRESS OF LANDOWNER <i>Jackie Havens</i>			
WELL LOCATION: SEC <u>31</u> TOWNSHIP <u>5<sup>N</sup></u> RANGE <u>7<sup>E</sup></u>			
DISTANCE <u>3</u> Miles	DIRECTION <u>NW</u>	NEAREST TOWN <u>Hamden</u>	
OTHER LANDMARK			
WELL PURPOSE <u>Home</u> Irrigation, Municipal, Industrial, Fish Pond, etc.			

<b>PUMP DATA</b>		
PUMP TYPE (Circle One): Submersible, Turbine, <u>Jet</u> Flowing Well, Other (Describe) _____		
POWER TYPE (Circle One): <u>Electric</u> , Tractor, Diesel, Gasoline, Butane, Other (Describe) _____ H/P <u>1</u>		
Pump Capacity (GPM) <u>8</u>	No. of Stages <u>2</u>	Setting Depth _____ FT.
PUMP TEST Well yielded _____ GPM with a drawdown of _____ ft. after _____ hours of pumping		

<b>WELL DATA</b>		
Well Depth <u>60'</u>	Casing Diameter (In.) <u>2"</u>	Casing Length (Ft.) <u>50'</u>
Type of Casing <u>PVC</u>	Hole Depth <u>60'</u>	Depth to Static Water Level <u>34'</u>
TYPE OF COMPLETION: (Circle One or More): <u>Natural Development</u> , Underreamed, Telescoped, Gravel Packed, Open Hole, Other		
Top of Lap Pipe or Reduction in Casing FEET. IF TELESCOPED OR MORE THAN ONE SCREEN: USE BACK PAGE		

<b>LOG DATA</b>	
TYPE OF LOG RUN (Circle One): Electric, Gamma Ray, Density, Sonic, Neutron, Other (Describe) <u>No Log Run</u>	
Name of Organization Running Log	

<b>SCREEN DATA</b>		
Diameter - Inches <u>2"</u>	Length - Feet <u>10'</u>	Slot Size - Inches <u>.008</u>
Screen Type <u>PVC</u>	Depth to Bottom - Feet <u>60'</u>	


<b>GEOLOGIC DATA (Office Use Only)</b>			
Surface Elev.	Geologic Unit	Unit Thickness	Depth to Top
Subs. SWL	Date	Analysis	Aquifer Test

DESCRIPTION OF FORMATIONS ENCOUNTERED	FROM	TO
<i>Red clay</i>	<i>0</i>	<i>23</i>
<i>pink fine sand</i>	<i>23</i>	<i>45</i>
<i>Red coarse sand</i>	<i>45</i>	<i>60</i>

Driller's Remarks	
<b>RECEIVED</b>	
OCT 07 1992	
Dept. of Environmental Quality Bureau of Land & Water Resources	
IF MORE SPACE IS NEEDED, USE BACK	

If well telescopes please sketch and show depths.

GROUND LEVEL

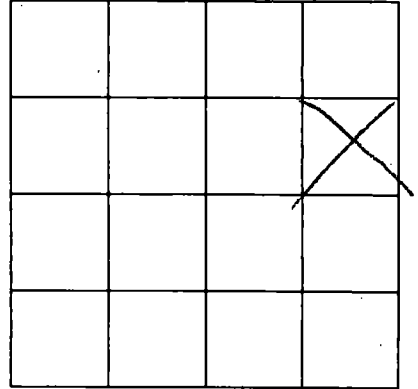

SECTION \_\_\_\_\_

Please indicate well location X.

ADDITIONAL INFORMATION

0101111111

0101111111

If more than one screen,  
show location of each on sketch.