

MISSISSIPPI DEPARTMENT OF ENVIRONMENTAL QUALITY
Bureau of Land and Water Resources

P. O. Box 10631
Jackson, MS 39289-0631
WATER WELL DRILLERS LOG

COUNTY WELL LOCATED <i>Jackson</i>	
WELL NUMBER <i>F 2211</i>	CODED
DATE WELL COMPLETED <i>5-21-92</i>	

PERMIT NUMBER
NAME OF DRILLING FIRM <i>Coast Water Well Dr. Inc.</i>

NAME & MAILING ADDRESS OF LANDOWNER <i>Paul Davis</i>			
WELL LOCATION: SEC <u>30</u> TOWNSHIP <u>5^N</u> RANGE <u>7^E</u>			
DISTANCE <u>4</u> Miles	DIRECTION <u>NW</u>	NEAREST TOWN <u>Hatchee</u>	
OTHER LANDMARK			
WELL PURPOSE: <u>Home</u> , Irrigation, Municipal, Industrial, Fish Pond, etc.			

PUMP DATA		
PUMP TYPE (Circle One): Submersible, Turbine, <u>Jet</u> Flowing Well, Other (Describe) _____		
POWER TYPE (Circle One): <u>Electric</u> , Tractor, Diesel, Gasoline, Butane, Other (Describe) <u>H/P 2</u>		
Pump Capacity (GPM) <u>6</u>	No. of Stages <u>3</u>	Setting Depth _____ FT.
PUMP TEST		
Well yielded _____ GPM with a drawdown of _____ ft. after _____ hours of pumping		

WELL DATA		
Well Depth <u>304'</u>	Casing Diameter (In.) <u>2"</u>	Casing Length (Ft.) <u>294'</u>
Type of Casing <u>PVC</u>	Hole Depth <u>309'</u>	Depth to Static Water Level <u>117'</u>
TYPE OF COMPLETION: (Circle One or More): <u>Gravel Packed</u> , Underreamed, Telescoped, Natural Development, Open Hole, Other (Describe) _____		
Top of Lap Pipe or Reduction in Casing FEET <u> </u> IF TELESCOPED OR MORE THAN ONE SCREEN: USE BACK PAGE		

LOG DATA	
TYPE OF LOG RUN (Circle One): Electric, Gamma Ray, Density, Sonic, Neutron, <u>No Log Run</u> , Other (Describe) _____	
Name of Organization Running Log _____	

SCREEN DATA		
Diameter - Inches <u>2"</u>	Length - Feet <u>10'</u>	Slot Size - Inches <u>.008</u>
Screen Type <u>PVC</u>	Depth to Bottom - Feet <u>304'</u>	


GEOLOGIC DATA (For Use Only)			
Surface Elev. _____	Geologic Unit _____	Depth to Top _____	Depth to Bottom _____
Subs. SWL _____	Date _____	Analysis _____	Analyzer Test _____
Driller's Remarks <u>OCT 07 1992</u>			
Dept. of Environmental Quality Bureau of Land & Water Resources			

DESCRIPTION OF FORMATIONS ENCOUNTERED	FROM	TO	FORMATIONS (Continued)	FROM	TO
<i>top soil</i>	<i>0</i>	<i>1</i>	<i>Blue Clay</i>	<i>304</i>	<i>309</i>
<i>Red clay</i>	<i>1</i>	<i>14</i>			
<i>Red coarse sand</i>	<i>14</i>	<i>92</i>			
<i>Blue Clay</i>	<i>92</i>	<i>104</i>			
<i>Red coarse sand</i>	<i>104</i>	<i>156</i>			
<i>Blue Clay</i>	<i>156</i>	<i>176</i>			
<i>Gray fine sand</i>	<i>176</i>	<i>188</i>			
<i>Blue Clay</i>	<i>188</i>	<i>193</i>			
<i>Gray fine sand</i>	<i>193</i>	<i>232</i>			
<i>Blue Clay</i>	<i>232</i>	<i>266</i>			
<i>Gray coarse sand</i>	<i>266</i>	<i>304</i>			

IF MORE SPACE IS NEEDED, USE BACK

If well telescopes please sketch and show depths.

GROUND LEVEL

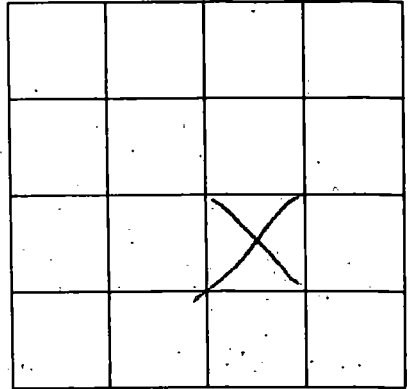

SECTION _____

Please indicate well location X.

ADDITIONAL INFORMATION

PROTECTED

Division of Water Resources
Bureau of Water Resources

If more than one screen,
show location of each on sketch.