

MISSISSIPPI DEPARTMENT OF ENVIRONMENTAL QUALITY
Bureau of Land and Water Resources

P. O. Box 10631
Jackson, MS 39289-0631
WATER WELL DRILLERS LOG

COUNTY WELL LOCATED <i>Jackson</i>	
WELL NUMBER <i>E 2918</i>	CODED <i>6-15-92</i>
DATE WELL COMPLETED	

PERMIT NUMBER <i>0408</i>
NAME OF DRILLING FIRM <i>Fuy Foghe Well Sa</i> <i>215 Box 3</i> <i>Sumedale MS 39652</i>

NAME & MAILING ADDRESS OF LANDOWNER <i>G. R. Mc Ferrin</i>		
<i>3314 Bark Ave</i>		
<i>Pascagoula MS 39581</i>		
WELL LOCATION: SEC	TOWNSHIP	RANGE
<i>27</i>	<i>5 N</i>	<i>R 7 E</i>
DISTANCE	DIRECTION	NEAREST TOWN
<i>12</i> Miles	<i>North</i>	<i>Vandale</i>
OTHER LANDMARK		
WELL PURPOSE: <input checked="" type="checkbox"/> Home Irrigation, Municipal, Industrial, Fish Pond, etc.		

PUMP DATA		
PUMP TYPE (Circle One): Submersible, Turbine, <input checked="" type="checkbox"/> Flowing Well, Other (Describe) _____		
POWER TYPE (Circle One): <input checked="" type="checkbox"/> Electric, Tractor, Diesel, Gasoline, Butane, Other (Describe) _____ H/P _____		
Pump Capacity (GPM) <i>5-10</i>	No. of Stages <i>3</i>	Setting Depth, <i>160</i> FT.
PUMP TEST		
Well yielded <i>5</i> GPM with a drawdown of <i>40</i> ft. after <i>4</i> hours of pumping		

WELL DATA		
Well Depth <i>294</i>	Casing Diameter (In.) <i>2"</i>	Casing Length (Ft.) <i>284</i>
Type of Casing <i>PVC</i>	Hole Depth <i>294</i>	Depth to Static Water Level <i>120'</i>
TYPE OF COMPLETION: (Circle One or More): <input checked="" type="checkbox"/> Gravel Packed, <input type="checkbox"/> Underreamed, <input type="checkbox"/> Telescoped, <input checked="" type="checkbox"/> Natural Development, <input type="checkbox"/> Open Hole, <input type="checkbox"/> Other (Describe) <i>air lift</i>		
Top of Lap Pipe or Reduction in Casing		
FEET		
IF TELESCOPED OR MORE THAN ONE SCREEN: USE BACK PAGE		

LOG DATA	
TYPE OF LOG RUN (Circle One): Electric, Gamma Ray, Density, Sonic, Neutron, Other (Describe) _____ No Log Run	
Name of Organization Running Log	

SCREEN DATA		
Diameter - Inches <i>2</i>	Length - Feet <i>16'</i>	Slot Size - Inches <i>#6</i>
Screen Type <i>Winged Johnson</i>	Depth to Bottom - Feet <i>294</i>	


GEOLOGIC DATA (Office Use Only)			
Surface Elev.	Geologic Unit	Unit Thickness	Depth to Top
Subs. SWL	Date	Analysis	Aquifer Test
Driller's Remarks			

DESCRIPTION OF FORMATIONS ENCOUNTERED	FROM	TO
<i>Top Soil</i>	<i>0</i>	<i>5</i>
<i>Weak Sand</i>	<i>5</i>	<i>20</i>
<i>Sand Pkts</i>	<i>20</i>	<i>40</i>
<i>Shells Sand & Clay</i>	<i>40</i>	<i>60</i>
<i>Clay</i>	<i>60</i>	<i>80</i>
<i>Clay</i>	<i>80</i>	<i>120</i>
<i>Peaty Sand</i>	<i>120</i>	<i>126</i>
<i>Clay</i>	<i>126</i>	<i>160</i>
<i>Clay</i>	<i>160</i>	<i>220</i>
<i>Shells in Sand & Clay</i>	<i>220</i>	<i>260</i>
<i>Hard Sand</i>	<i>260</i>	<i>294</i>

FORMATIONS (Continued)	FROM	TO
RECEIVED		
SEP 01 1992		
Dept. of Environmental Quality Bureau of Land & Water Resources		
IF MORE SPACE IS NEEDED, USE BACK		

If well telescopes please
sketch and show depths.


GROUND LEVEL

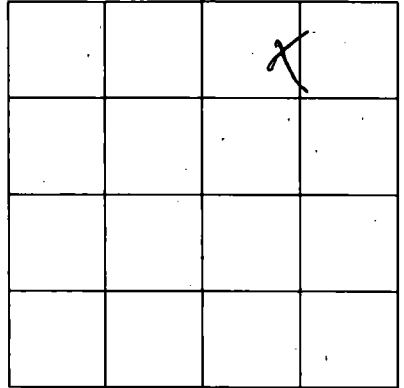

SECTION 27

Please indicate well location X.

ADDITIONAL INFORMATION

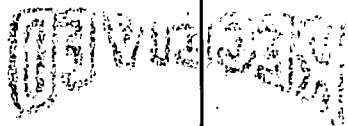

If more than one screen,
show location of each on sketch.