

MISSISSIPPI DEPARTMENT OF ENVIRONMENTAL QUALITY

Office of Land and Water Resources

P. O. Box 10631
Jackson, MS 39289-0631

WATER WELL DRILLERS LOG

COUNTY WELL LOCATED <i>Jackson</i>	
WELL NUMBER <i>F-2241</i>	CODED
DATE WELL COMPLETED <i>10-13-93</i>	

PERMIT NUMBER
NAME OF DRILLING FIRM <i>Coast Water Well Driller Inc.</i>

NAME & MAILING ADDRESS OF LANDOWNER <i>Steve Jones</i>			
<i>Springlake Dr.</i>			
<i>Vanclave, Ms. 39565</i>			
WELL LOCATION:	SEC	TOWNSHIP	RANGE
	<i>29</i>	<i>5</i>	<i>7 E</i>
DISTANCE	DIRECTION	NEAREST TOWN	
<i>3</i> Miles	<i>N</i>	of <i>Vanclave</i>	
OTHER LANDMARK			
WELL PURPOSE <input checked="" type="checkbox"/> Home <input type="checkbox"/> Irrigation, Municipal, Industrial, Fish Pond, etc.			

PUMP DATA		
PUMP TYPE (Circle One): Submersible, Turbine, <input checked="" type="checkbox"/> Jet <input type="checkbox"/> Flowing Well, Other (Describe) _____		
POWER TYPE (Circle One): <input checked="" type="checkbox"/> Electric <input type="checkbox"/> Tractor, Diesel, Gasoline, Butane, Other (Describe) _____ H/P <i>2</i>		
Pump Capacity (GPM) <i>9</i>	No. of Stages <i>3</i>	Setting Depth FT.
PUMP TEST		
Well yielded _____ GPM with a drawdown of _____ ft. after _____ hours of pumping		

WELL DATA		
Well Depth <i>275'</i>	Casing Diameter (In.), <i>2"</i>	Casing Length (Ft.) <i>265'</i>
Type of Casing <i>PVC</i>	Hole Depth <i>275'</i>	Depth to Static Water Level <i>105'</i>
TYPE OF COMPLETION: (Circle One or More): <input checked="" type="checkbox"/> Gravel Packed, <input type="checkbox"/> Underreamed, <input type="checkbox"/> Telescoped, <input checked="" type="checkbox"/> Natural Development, <input type="checkbox"/> Open Hole, <input type="checkbox"/> Other (Describe) _____		
WELL GROUTED TO A DEPTH OF <i>20</i> FEET Type Grout (circle one): Cement, <input checked="" type="checkbox"/> Bentonite, or Mix		

LOG DATA	
TYPE OF LOG RUN (Circle One): <input checked="" type="checkbox"/> Log Run Electric, Gamma Ray, Density, Sonic, Neutron, Other (Describe) _____	
Name of Organization Running Log	

SCREEN DATA		
Diameter - Inches <i>2"</i>	Length - Feet <i>10'</i>	Slot Size - Inches <i>.008</i>
Screen Type <i>PVC</i>	Depth to Bottom - Feet <i>275'</i>	


GEOLOGIC DATA (Office Use Only)			
Surface Elev.	Geologic Unit	Unit Thickness	Depth to Top
Subs. SWL	Date	Analysis	Aquifer Test
Driller's Remarks			

DESCRIPTION OF FORMATIONS ENCOUNTERED	FROM	TO
<i>Top soil</i>	<i>0</i>	<i>20</i>
<i>yellow/grey clay</i>	<i>20</i>	<i>60</i>
<i>fine to coarse sand</i>	<i>60</i>	<i>100</i>
<i>Blue Clay Silt sand</i>	<i>100</i>	<i>230</i>
<i>Med. sand</i>	<i>230</i>	<i>275</i>

FORMATIONS (Continued)	FROM	TO
RECEIVED		
DEC 14 1993		
Dept. of Environmental Quality Office of Land & Water Resources		
IF MORE SPACE IS NEEDED, USE BACK		

If well telescopes please sketch and show depths.

GROUND LEVEL

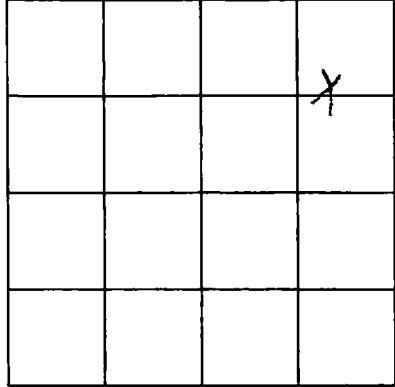

SECTION 29

Please indicate well location X.

ADDITIONAL INFORMATION

Multiple horizontal lines for providing additional information.

If more than one screen, show location of each on sketch.