

**MISSISSIPPI DEPARTMENT OF ENVIRONMENTAL QUALITY**

Office of Land and Water Resources

P. O. Box 10631  
Jackson, MS 39289-0631  
**WATER WELL DRILLERS LOG**

COUNTY WELL LOCATED <b>Jackson</b>	
WELL NUMBER <b>F 2282</b>	CODED
DATE WELL COMPLETED <b>10-26-95</b>	

PERMIT NUMBER
NAME OF DRILLING FIRM <b>Coast Water Well Service</b>

NAME & MAILING ADDRESS OF LANDOWNER <b>Dennis Carnley</b> <b>Hillside Drive</b> <b>Vance, Ms</b>			
WELL LOCATION:	SEC	TOWNSHIP	RANGE
	<b>33</b>	<b>5<sup>th</sup></b>	<b>7<sup>th</sup></b>
DISTANCE	DIRECTION	NEAREST TOWN	
<b>2</b> Miles	<b>NW</b>	of <b>Vance</b>	
OTHER LANDMARK			
WELL PURPOSE (Circle one): <input checked="" type="radio"/> Home, <input type="radio"/> Irrigation, <input type="radio"/> Municipal, <input type="radio"/> Industrial, <input type="radio"/> Fish Pond, etc.			

PUMP DATA		
PUMP TYPE (Circle One): Submersible, Turbine, <input checked="" type="radio"/> Jet, <input type="radio"/> Flowing Well, Other (Describe) _____		
POWER TYPE (Circle One): <input checked="" type="radio"/> Electric, <input type="radio"/> Tractor, <input type="radio"/> Diesel, <input type="radio"/> Gasoline, <input type="radio"/> Butane, Other (Describe) _____ H/P <b>1</b>		
Pump Capacity (GPM) <b>8</b>	No. of Stages <b>2</b>	Setting Depth <b>FT.</b>
PUMP TEST		
Well yielded _____ GPM with a drawdown of _____ ft. after _____ hours of pumping		


WELL DATA		
Well Depth <b>260'</b>	Casing Diameter (In.) <b>2"</b>	Casing Length (Fl.) <b>250'</b>
Type of Casing <b>PVC</b>	Hole Depth <b>260'</b>	Depth to Static Water Level <b>55'</b>
TYPE OF COMPLETION: (Circle One or More): <input checked="" type="radio"/> Gravel Packed, <input type="radio"/> Underreamed, <input type="radio"/> Telescoped, <input checked="" type="radio"/> Natural Development, <input type="radio"/> Open Hole, <input type="radio"/> Other (Describe) _____		
WELL GROUTED TO A DEPTH OF <b>20</b> FEET Type Grout (circle one): <input checked="" type="radio"/> Cement, <input type="radio"/> Bentonite, or <input type="radio"/> Mix		

LOG DATA	
TYPE OF LOG RUN (Circle One): <input checked="" type="radio"/> No Log Run, <input type="radio"/> Electric, <input type="radio"/> Gamma Ray, <input type="radio"/> Density, <input type="radio"/> Sonic, <input type="radio"/> Neutron, Other (Describe) _____	
Name of Organization Running Log	

SCREEN DATA		
Diameter - Inches <b>2"</b>	Length - Feet <b>10'</b>	Slot Size - Inches <b>.008</b>
Screen Type <b>PVC</b>	Depth to Bottom - Feet <b>260'</b>	

GEOLOGIC DATA (Office Use Only)			
Surface Elev.	Geologic Unit	Unit Thickness	Depth to Top
Subs. SWL	Date	Analysis	Aquifer Test
Driller's Remarks			

DESCRIPTION OF FORMATIONS ENCOUNTERED	FROM	TO	FORMATIONS (Continued)	FROM	TO
Top Soil	0	2			
Orange pink clay	2	40			
Fine-Med sand	40	90			
Blue Clay	90	140			
Med sand	140	160			
Blue Clay streaked	160	220			
Med-Coarse sand	220	260			

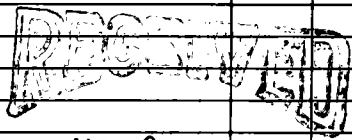

NOV 09 1995

Dept. of Environmental Quality  
Office of Land & Water Resources

IF MORE SPACE IS NEEDED, USE BACK

If well telescopes please  
sketch and show depths.

GROUND LEVEL

X			

SECTION 33

Please indicate well location X.

ADDITIONAL INFORMATION

If more than one screen,  
show location of each on sketch.