

MISSISSIPPI DEPARTMENT OF ENVIRONMENTAL QUALITY

Office of Land and Water Resources

P. O. Box 10631
Jackson, MS 39289-0631
WATER WELL DRILLERS LOG

COUNTY WELL LOCATED
Jackson

WELL NUMBER **F 2289** CODED

DATE WELL COMPLETED
3-14-96

PERMIT NUMBER

NAME OF DRILLING FIRM
Coast Water Well Service

NAME & MAILING ADDRESS OF LANDOWNER
**Glenn Ryder
CCC Rd
Vandave Ms**

WELL LOCATION: SEC **8** TOWNSHIP **5 S** RANGE **7 E**

DISTANCE **6** Miles **NORTH** of **Vandave**

OTHER LANDMARK

WELL PURPOSE Home, Irrigation, Municipal, Industrial, Fish Pond, etc.

PUMP DATA

PUMP TYPE (Circle One): Submersible Turbine, ~~Flowing Well~~
Other (Describe)

POWER TYPE (Circle One): Electric Tractor, Diesel, Gasoline, Butane.
Other (Describe) H/P 1

Pump Capacity (GPM)	No. of Stages	Setting Depth
10	11	180 FT.

PUMP TEST

Well yielded _____ GPM with
a drawdown of _____ ft.
after _____ hours of pumping

WELL DATA

Well Depth 270'	Casing Diameter (In.) 4"	Casing Length (Ft.) 260'
Type of Casing PVC	Hole Depth 270'	Depth to Static Water Level 140'

LOG DATA

TYPE OF LOG RUN (Circle One): No Log Run
Electric, Gamma Ray, Density, Sonic, Neutron,
Other (Describe)

Name of Organization Running Log

TYPE OF COMPLETION: (Circle One or More):
Natural Development Gravel Packed, Underreamed, Telescoped,
Open Hole, Other

WELL GROUTED TO A DEPTH OF **80** FEET
Type Grout (circle one): Cement, Bentonite, or Mix

GEOLOGIC DATA (Office Use Only)

Surface Elev.	Geologic Unit	Unit Thickness	Depth to Top
Subs. SWL	Date	Analysis	Aquifer Test

SCREEN DATA

Diameter - Inches 4"	Length - Feet 10'	Slot Size - Inches .008
Screen Type PVC	Depth to Bottom - Feet 270	

Driller's Remarks

Top of Lap Pipe or Reduction in Casing

FEET IF TELESCOPED OR MORE THAN ONE SCREEN: USE BACK PAGE

DESCRIPTION OF FORMATIONS ENCOUNTERED	FROM	TO
Top Soil	0	2
Orange Clay	2	18
Med Sand	18	25
Pink Orange Blue Clay	25	160
Med Sand	160	175
Blue Clay	175	215
Fine Med Sand	215	270

FORMATIONS (continued):

REGULATORY


MAY 14 1996

Dept. of Environmental Quality
Office of Land & Water Resources

IF MORE SPACE IS NEEDED, USE BACK

If well telescopes please sketch and show depths.

GROUND LEVEL

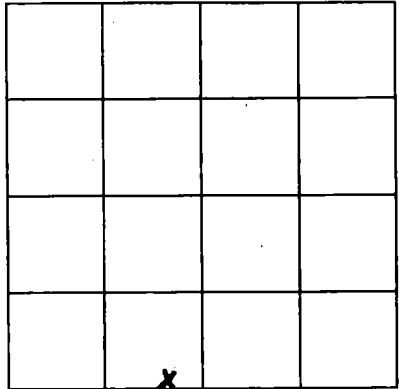

SECTION 8

Please indicate well location X.

ADDITIONAL INFORMATION

If more than one screen, show location of each on sketch.