

**MISSISSIPPI DEPARTMENT OF ENVIRONMENTAL QUALITY**

Office of Land and Water Resources

P. O. Box 10631  
Jackson, MS 39289-0631  
**WATER WELL DRILLERS LOG**

COUNTY WELL LOCATED <i>Jackson</i>	
WELL NUMBER <i>F 2293</i>	CODED
DATE WELL COMPLETED <i>1-12-96</i>	

PERMIT NUMBER
NAME OF DRILLING FIRM <i>Coastal Water Well Service</i>

NAME & MAILING ADDRESS OF LANDOWNER <i>Ed Reiter</i>			
<i>Blackfoot Rd</i>			
<i>Doncleave, Ms.</i>			
WELL LOCATION	SEC	TOWNSHIP	RANGE
	<i>- 35</i>	<i>5</i>	<i>7E</i>
DISTANCE	DIRECTION	NEAREST TOWN	
<i>4</i> Miles	<i>NE</i>	of <i>Doncleave</i>	
OTHER LANDMARK			
WELL PURPOSE: Home, Irrigation, Municipal, Industrial, Fish Pond, etc.			

<b>PUMP DATA</b>		
PUMP TYPE (Circle One): Submersible, Turbine, <u>Jet</u> Flowing Well, Other (Describe) _____		
POWER TYPE (Circle One): <u>Electric</u> , Tractor, Diesel, Gasoline, Butane, Other (Describe) _____ H/P <u>2</u>		
Pump Capacity (GPM) <i>10</i>	No. of Stages <i>2</i>	Setting Depth  <b>FT.</b>
PUMP TEST Well yielded _____ GPM with a drawdown of _____ ft. after _____ hours of pumping		

<b>WELL DATA</b>		
Well Depth <i>268'</i>	Casing Diameter (In.) <i>2"</i>	Casing Length (Ft.) <i>258'</i>
Type of Casing <i>PVC</i>	Hole Depth <i>268'</i>	Depth to Static Water Level <i>80'</i>
TYPE OF COMPLETION: (Circle One or More): <del>Gravel Packed</del> Underreamed, Telescoped, <u>Natural Development</u> , Open Hole, Other		


<b>LOG DATA</b>	
TYPE OF LOG RUN (Circle One): Electric, Gamma Ray, Density, Sonic, <u>No Log Run</u> , Other (Describe) _____	
Name of Organization Running Log	

WELL GROUTED TO A DEPTH OF <i>20</i> FEET Type Grout (circle one): Cement, <u>Bentonite</u> or Mix
---

<b>GEOLOGIC DATA (Office Use Only)</b>			
Surface Elev.	Geologic Unit	Unit Thickness	Depth to Top
Subs. SWL	Date	Analysis	Aquifer Test
Driller's Remarks			
Top of Lap Pipe or Reduction in Casing			
<b>FEET</b>		IF TELESCOPED OR MORE THAN ONE SCREEN: USE BACK PAGE	


<b>SCREEN DATA</b>		
Diameter - Inches <i>2"</i>	Length - Feet <i>10'</i>	Slot Size - Inches <i>.008</i>
Screen Type <i>PVC</i>	Depth to Bottom - Feet <i>268'</i>	

DESCRIPTION OF FORMATIONS ENCOUNTERED	FROM	TO
<i>Top Soil</i>	<i>0</i>	<i>2</i>
<i>fine coarse sand</i>	<i>2</i>	<i>40</i>
<i>Blue Gray streaky sand</i>	<i>40</i>	<i>220</i>
<i>Med-Coarse sand</i>	<i>220</i>	<i>268</i>

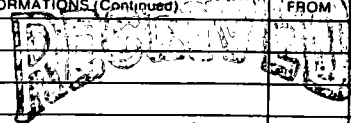FORMATIONS (Continued)	FROM	TO
		
<i>APR 01 1996</i>		
Dept. of Environmental Quality Office of Land & Water Resources		
IF MORE SPACE IS NEEDED, USE BACK		

If well telescopes please sketch and show depths.

GROUND LEVEL

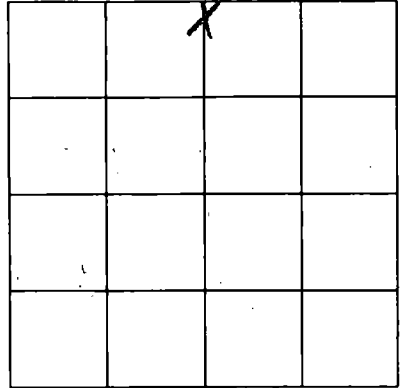

SECTION

35

Please indicate well location X.

ADDITIONAL INFORMATION

If more than one screen,  
show location of each on sketch.