

MISSISSIPPI DEPARTMENT OF ENVIRONMENTAL QUALITY

Office of Land and Water Resources

P. O. Box 10631

Jackson, MS 39289-0631

WATER WELL DRILLERS LOG

COUNTY WELL LOCATED Jackson	
WELL NUMBER F-2384	CODED
DATE WELL COMPLETED 4-7-97	

PERMIT NUMBER
NAME OF DRILLING FIRM Coast Water Well Service

NAME & MAILING ADDRESS OF LANDOWNER Betty Dillon Old Kelly Rd. Vandeventer Mo.			
WELL LOCATION	SEC	TOWNSHIP	RANGE
	28	5	7
DISTANCE	DIRECTION	NEAREST TOWN	
3 1/2 Miles	NORTH	of Vandeventer	
OTHER LANDMARK			
WELL PURPOSE: <input checked="" type="radio"/> Home Irrigation, <input type="radio"/> Municipal, <input type="radio"/> Industrial, <input type="radio"/> Fish Pond, etc.			

PUMP DATA		
PUMP TYPE (Circle One): Submersible, Turbine, <input checked="" type="radio"/> Flowing Well , Other (Describe) _____		
POWER TYPE (Circle One): <input checked="" type="radio"/> Electric, Tractor, Diesel, Gasoline, Butane, Other (Describe) _____ H/P 2		
Pump Capacity (GPM) 11	No. of Stages 3	Setting Depth FT.
PUMP TEST		
Well yielded _____ GPM with a drawdown of _____ ft. after _____ hours of pumping		

WELL DATA		
Well Depth 265'	Casing Diameter (In.) 2"	Casing Length (Ft.) 255'
Type of Casing PVC	Hole Depth 265'	Depth to Static Water Level 75'

TYPE OF COMPLETION: (Circle One or More):
 Gravel Packed, Underreamed, Telescoped,
 Natural Development, Open Hole, Other
 (Describe) _____

WELL GROUTED TO A DEPTH OF **20** FEET
 Type Grout (circle one): Cement, Bentonite, or Mix

SCREEN DATA		
Diameter - Inches 2"	Length - Feet 10'	Slot Size - Inches .008
Screen Type PVC	Depth to Bottom - Feet 265'	

LOG DATA	
TYPE OF LOG RUN (Circle One): Electric, Gamma Ray, Density, <input checked="" type="radio"/> No Log Run , Sonic, Neutron , Other (Describe) _____	
Name of Organization Running Log	

GEOLOGIC DATA (Office Use Only)			
Surface Elev.	Geologic Unit	Unit Thickness	Depth to Top
Subs. SWL	Date	Analysis	Aquifer Test

Driller's Remarks

Top of Lap Pipe or Reduction in Casing


FEET	IF TELESCOPED OR MORE THAN ONE SCREEN: USE BACK PAGE
------	--

DESCRIPTION OF FORMATIONS ENCOUNTERED	FROM	TO
Top Soil	0	2
Brown Clay	2	60
White sandstone	60	70
White Clay	70	74
White sandstone	74	105
Blue Clay	105	240
gray coarse sand	240	265

FORMATIONS (Continued)	FROM	TO
RECEIVED		
JUL 21 1997		
Dept. of Environmental Quality Office of Land & Water Resources		
IF MORE SPACE IS NEEDED, USE BACK		

If well telescopes please sketch and show depths.

GROUND LEVEL

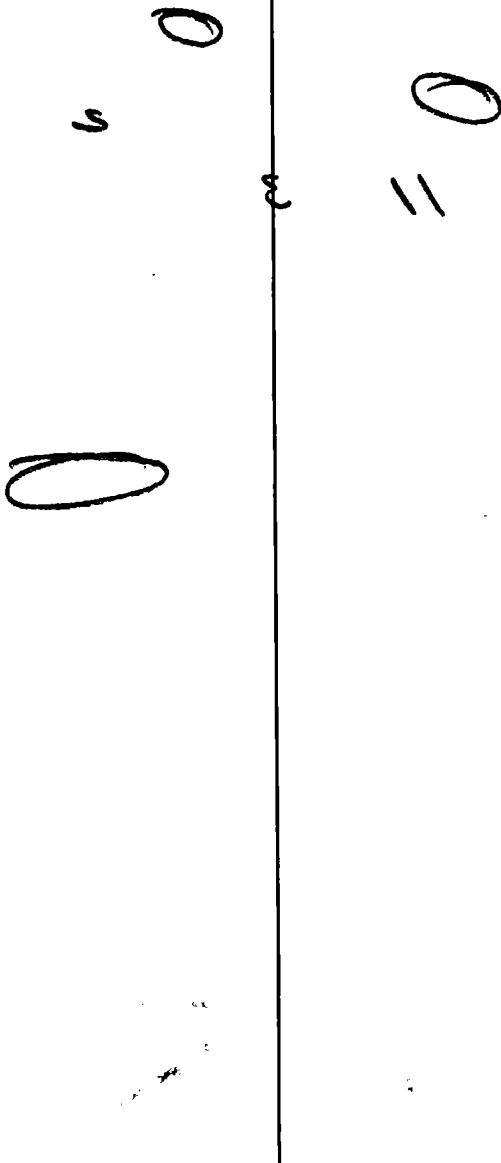

Handwritten notes in the table area, including "North", "28", "3/4", and other illegible scribbles.

SECTION

28

Please indicate well location X.

ADDITIONAL INFORMATION

Lined area for additional information.

If more than one screen, show location of each on sketch.