

**MISSISSIPPI DEPARTMENT OF ENVIRONMENTAL QUALITY**

Office of Land and Water Resources

P. O. Box 10631  
Jackson, MS 39289-0631  
**WATER WELL DRILLERS LOG**

COUNTY WELL LOCATED <i>Jackson</i>	
WELL NUMBER <i>F2329</i>	CODED
DATE WELL COMPLETED <i>5-14-97</i>	

PERMIT NUMBER
NAME OF DRILLING FIRM <i>Coastal Water Well Service</i>

NAME & MAILING ADDRESS OF LANDOWNER <i>Tom Barrett</i>			
<i>Bushy Rd.</i>			
<i>Vanclave, Ms</i>			
WELL LOCATION:	SEC	TOWNSHIP	RANGE
	<i>8</i>	<i>5</i>	<i>7</i>
DISTANCE	DIRECTION	NEAREST TOWN	
<i>6</i> Miles	<i>NORTH</i>	<i>Vanclave</i>	
OTHER LANDMARK			
WELL PURPOSE (Home, Irrigation, Municipal, Industrial, Fish Pond, etc.) <input checked="" type="radio"/> Home			

<b>PUMP DATA</b>		
PUMP TYPE (Circle One): Submersible, Turbine, <input checked="" type="radio"/> Jet, Flowing Well, Other (Describe) _____		
POWER TYPE (Circle One): <input checked="" type="radio"/> Electric, Tractor, Diesel, Gasoline, Butane, Other (Describe) _____ H/P <i>2</i>		
Pump Capacity (GPM) <i>6</i>	No. of Stages <i>3</i>	Setting Depth <i>FT.</i>
PUMP TEST		
Well yielded _____ GPM with a drawdown of _____ ft. after _____ hours of pumping		

<b>WELL DATA</b>		
Well Depth <i>360'</i>	Casing Diameter (In.) <i>2"</i>	Casing Length (Ft.) <i>350'</i>
Type of Casing <i>PVC</i>	Hole Depth <i>360'</i>	Depth to Static Water Level <i>130'</i>
TYPE OF COMPLETION: (Circle One or More): <input checked="" type="radio"/> Gravel Packed, <input type="radio"/> Underreamed, <input type="radio"/> Telescoped, <input checked="" type="radio"/> Natural Development, <input type="radio"/> Open Hole, <input type="radio"/> Other (Describe) _____		
WELL GROUTED TO A DEPTH OF <i>20</i> FEET Type Grout (circle one): Cement, Bentonite, or Mix		

<b>LOG DATA</b>	
TYPE OF LOG RUN (Circle One): Electric, Gamma Ray, Density, Sonic, <input checked="" type="radio"/> Neutron, Other (Describe) _____	
Name of Organization Running Log	

<b>SCREEN DATA</b>		
Diameter - Inches <i>2"</i>	Length - Feet <i>10'</i>	Slot Size - Inches <i>.004</i>
Screen Type <i>PVC Wrapped</i>	Depth to Bottom - Feet <i>360'</i>	


<b>GEOLOGIC DATA (Office Use Only)</b>			
Surface Elev.	Geologic Unit	Unit Thickness	Depth to Top
Subs. SWL	Date	Analysis	Aquifer Test
Driller's Remarks			
Top of Lap Pipe or Reduction in Casing			
FEET			
IF TELESCOPED OR MORE THAN ONE SCREEN: USE BACK PAGE			

DESCRIPTION OF FORMATIONS ENCOUNTERED	FROM	TO	FORMATIONS (Continued)	FROM	TO
<i>Top Soil</i>	<i>0</i>	<i>2</i>	<b>RECEIVED</b>  <i>JUL 21 1997</i>  Dept. of Environmental Quality Office of Land & Water Resources		
<i>Red sand</i>	<i>2</i>	<i>19</i>			
<i>White coarse sand</i>	<i>19</i>	<i>40</i>			
<i>Blue Clay streak sand</i>	<i>40</i>	<i>335</i>			
<i>Med gray sand</i>	<i>335</i>	<i>360</i>			

IF MORE SPACE IS NEEDED, USE BACK

If well telescopes please sketch and show depths.

GROUND LEVEL

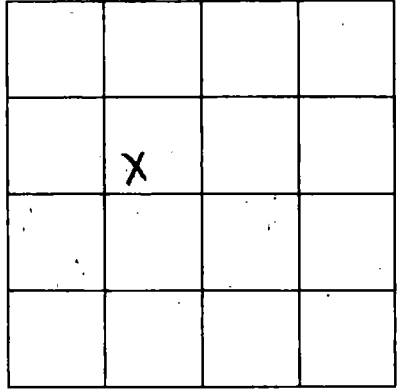

SECTION 8

Please indicate well location X.

ADDITIONAL INFORMATION

If more than one screen,  
show location of each on sketch.