

MISSISSIPPI DEPARTMENT OF ENVIRONMENTAL QUALITY

Office of Land and Water Resources

P. O. Box 10631

Jackson, MS 39289-0631

WATER WELL DRILLERS LOG

COUNTY WELL LOCATED  
**Jackson**  
 WELL NUMBER CODED  
**F-2386**  
 DATE WELL COMPLETED  
**6-15-99**

PERMIT NUMBER  
 NAME OF DRILLING FIRM  
**Coast Water Well Service**

NAME & MAILING ADDRESS OF LANDOWNER  
**Ed Stover**  
**Old Kelly Rd.**  
**Vandeventer, Ms**  
 WELL LOCATION: SEC TOWNSHIP RANGE  
**28 5 7**  
 DISTANCE DIRECTION NEAREST TOWN  
**4** Miles **NORTH** of **Vandeventer**  
 OTHER LANDMARK  
 WELL PURPOSE  Home Irrigation, Municipal, Industrial, Fish Pond, etc.

PUMP DATA  
 PUMP TYPE (Circle One): Submersible, Turbine,  Jet, Flowing Well, Other (Describe) \_\_\_\_\_  
 POWER TYPE (Circle One): Electric, Tractor, Diesel, Gasoline, Butane, Other (Describe) \_\_\_\_\_ H/P **2**  
 Pump Capacity (GPM) No. of Stages Setting Depth  
**8.5** **3** \_\_\_\_\_ FT.  
 PUMP TEST  
 Well yielded \_\_\_\_\_ GPM with a drawdown of \_\_\_\_\_ ft. after \_\_\_\_\_ hours of pumping

WELL DATA  
 Well Depth Casing Diameter (In.) Casing Length (Ft.)  
**270'** **8"** **260'**  
 Type of Casing Hole Depth Depth to Static Water Level  
**PVC** **270'** **80'**

LOG DATA  
 TYPE OF LOG RUN (Circle One): Electric, Gamma Ray, Density, Sonic,  No Log Run, Neutron, Other (Describe) \_\_\_\_\_  
 Name of Organization Running Log

TYPE OF COMPLETION: (Circle One or More): Gravel Packed, Underreamed, Telescoped,  Natural Development, Open Hole, Other (Describe) \_\_\_\_\_  
 WELL GROUTED TO A DEPTH OF **20** FEET  
 Type Grout (circle one): Cement,  Bentonite, or Mix

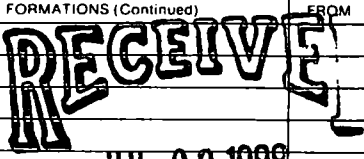
GEOLOGIC DATA (Office Use Only)  

Surface Elev.	Geologic Unit	Unit Thickness	Depth to Top
Subs. SWL	Date	Analysis	Aquifer Test

SCREEN DATA  
 Diameter - Inches Length - Feet Slot Size - Inches  
**2"** **10'** **.008**  
 Screen Type Depth to Bottom - Feet  
**PVC** **270'**

Driller's Remarks  
 Top of Lap Pipe or Reduction in Casing  
 FEET IF TELESCOPED OR MORE THAN ONE SCREEN: USE BACK PAGE

DESCRIPTION OF FORMATIONS ENCOUNTERED	FROM	TO
Top Soil	0	2
Bibun Clay	2	40
Med gray sand	40	125
Blue Clay	125	240
gray coarse sand	240	270

FORMATIONS (Continued) FROM TO  
  
**JUL 09 1999**  
 Dept of Environmental Quality  
 Office of Land & Water Resources  
 IF MORE SPACE IS NEEDED, USE BACK

If well telescopes please  
sketch and show depths.

GROUND LEVEL

			X

SECTION 28

Please indicate well location X.

ADDITIONAL INFORMATION

RECEIVED

Ground level is indicated  
by a dashed line.

If more than one screen,  
show location of each on sketch.