

**MISSISSIPPI DEPARTMENT OF ENVIRONMENTAL QUALITY**

Office of Land and Water Resources

P. O. Box 10631  
Jackson, MS 39289-0631  
**WATER WELL DRILLERS LOG**

COUNTY WELL LOCATED <i>Jackson</i>	
WELL NUMBER <i>F2398</i>	CODED
DATE WELL COMPLETED <i>1-25-00</i>	

PERMIT NUMBER <i>0-408</i>
NAME OF DRILLING FIRM <i>Fr 4 F 0 9 1 K Well Ser.</i>
<i>1948 Spat Rd Succedale MS 39452</i>

NAME & MAILING ADDRESS OF LANDOWNER <i>Eddie Anderson</i>			
<i>PO Box 1103</i>			
<i>Pascagoula MS 39568 1103</i>			
WELL LOCATION <i>Von Cleve 5</i>	SECTION <i>39</i>	TOWNSHIP <i>T5</i>	RANGE <i>N7</i>
DISTANCE <i>2</i>	DIRECTION <i>S</i>	NEAREST TOWN <i>Wade Von Cleve</i>	
OTHER LANDMARK <i>old River Road River Bluffs</i>			
WELL PURPOSE: <input type="checkbox"/> Home <input type="checkbox"/> Irrigation, <input type="checkbox"/> Municipal, <input type="checkbox"/> Industrial, <input type="checkbox"/> Fish Pond, etc.			

<b>PUMP DATA</b>		
PUMP TYPE (Circle One): Submersible, Turbine, <u>Jet</u> Flowing Well, Other (Describe) _____		
POWER TYPE (Circle One): Electric, Tractor, Diesel, Gasoline, Butane, Other (Describe) <u>2</u> H/P _____		
Pump Capacity (GPM)	No. of Stages	Setting Depth  FT.
PUMP TEST		
Well yielded _____ GPM with a drawdown of _____ ft. after _____ hours of pumping		

<b>WELL DATA</b>		
Well Depth <i>270'</i>	Casing Diameter (In.) <i>2"</i>	Casing Length (Ft.) <i>260'</i>
Type of Casing <i>PVC</i>	Hole Depth	Depth to Static Water Level

<b>LOG DATA</b>	
TYPE OF LOG RUN (Circle One): Electric, Gamma Ray, Density, Sonic, Neutron, Other (Describe) _____	
Name of Organization Running Log	

TYPE OF COMPLETION: (Circle One or More):  
Gravel Packed, Underreamed, Telescoped,  
Natural Development, Open Hole, Other (Describe) \_\_\_\_\_

<b>GEOLOGIC DATA (Office Use Only)</b>			
Surface Elev.	Geologic Unit	Unit Thickness	Depth to Top
Subs. SWL	Date	Analysis	Aquifer Test

WELL GROUTED TO A DEPTH OF 20 FEET  
Type Grout (circle one): Cement, Bentonite, or Mix

<b>SCREEN DATA</b>		
Diameter - Inches <i>2"</i>	Length - Feet <i>10'</i>	Slot Size - Inches <i>#8 wrap</i>
Screen Type <i>PVC</i>	Depth to Bottom - Feet	


Driller's Remarks	
Top of Lap Pipe or Reduction in Casing	
FEET	IF TELESCOPED OR MORE THAN ONE SCREEN: USE BACK PAGE

DESCRIPTION OF FORMATIONS ENCOUNTERED	FROM	TO	FORMATIONS (Continued)	FROM	TO
<i>top soil</i>	<i>0</i>	<i>10</i>	<i>Clay Silt</i>	<i>110</i>	<i>120</i>
<i>fine to med sand</i>	<i>10</i>	<i>20</i>	<i>Clay</i>	<i>120</i>	<i>130</i>
<i>med sand</i>	<i>20</i>	<i>40</i>	<i>fine sand</i>	<i>130</i>	<i>140</i>
<i>med sand</i>	<i>40</i>	<i>50</i>	<i>fine to med sand</i>	<i>140</i>	<i>150</i>
<i>Rock Sand</i>	<i>50</i>	<i>51</i>	<i>Silt</i>	<i>150</i>	<i>160</i>
<i>shale coarse</i>	<i>51</i>	<i>58</i>	<i>Silt + clay</i>	<i>160</i>	<i>180</i>
<i>Clay</i>	<i>58</i>	<i>62</i>	<i>Clay</i>	<i>180</i>	<i>190</i>
<i>fine to med sand</i>	<i>62</i>	<i>75</i>	<i>fine to med sand</i>	<i>190</i>	<i>200</i>
<i>Silt clay</i>	<i>75</i>	<i>80</i>	<i>Clay</i>	<i>200</i>	<i>210</i>
<i>Silt</i>	<i>80</i>	<i>105</i>	<i>Sand</i>	<i>210</i>	<i>220</i>
<i>Clay</i>	<i>105</i>	<i>110</i>			

*over*

If well telescopes please sketch and show depths.

GROUND LEVEL

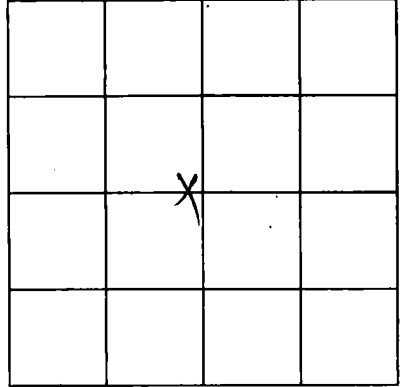

SECTION 59

Please indicate well location X.

ADDITIONAL INFORMATION

200-250 Silt to coarse Fine sand  
250-260 Fine to med sand  
260-270 med Sand

If more than one screen, show location of each on sketch.