

MISSISSIPPI DEPARTMENT OF ENVIRONMENTAL QUALITY
Office of Land and Water Resources

P. O. Box 10631
 Jackson, MS 39289-0631
WATER WELL DRILLERS LOG

COUNTY WELL LOCATED	
Jackson	
WELL NUMBER	CODED
F-2759	
DATE WELL COMPLETED	
2-16-01	

PERMIT NUMBER
NAME OF DRILLING FIRM
Central Water Well Service

NAME & MAILING ADDRESS OF LANDOWNER			
Michael Orr			
Old River Rd.			
Vandevae, Ms, 39525			
WELL LOCATION	SEC	TOWNSHIP	RANGE
	23	5 ^N	7 ^E
DISTANCE	DIRECTION	NEAREST TOWN	
5	Miles NE	of Vandevae	
OTHER LANDMARK			
WELL PURPOSE <input checked="" type="radio"/> Home, <input type="radio"/> Irrigation, <input type="radio"/> Municipal, <input type="radio"/> Industrial, <input type="radio"/> Fish Pond, etc.			

PUMP DATA			
PUMP TYPE (Circle One):			
Submersible.	Turbine.	<input checked="" type="radio"/> Jet	Flowing Well.
Other (Describe) _____			
POWER TYPE (Circle One):			
<input checked="" type="radio"/> Electric.	Tractor.	Diesel.	Gasoline, Butane.
Other (Describe) _____			
Pump Capacity (GPM)	No. of Stages	Setting Depth	
6	2	_____ FT.	
PUMP TEST			
Well yielded _____ GPM with			
a drawdown of _____ ft.			
after _____ hours of pumping			

WELL DATA		
Well Depth	Casing Diameter (In.)	Casing Length (Ft.)
64'	2"	54'
Type of Casing	Hole Depth	Depth to Static Water Level
PVC	64'	45'
TYPE OF COMPLETION: (Circle One or More):		
<input checked="" type="checkbox"/> Gravel Packed.	<input type="checkbox"/> Underreamed.	<input type="checkbox"/> Telescoped.
<input checked="" type="checkbox"/> Natural Development	<input type="checkbox"/> Open Hole.	<input type="checkbox"/> Other
(Describe) _____		
WELL GROUTED TO A DEPTH OF 10 FEET		
Type Grout (circle one): Cement, <input checked="" type="checkbox"/> Bentonite, or Mix		

LOG DATA	
TYPE OF LOG RUN (Circle One):	
<input type="checkbox"/> Electric.	<input checked="" type="checkbox"/> No Log Run.
<input type="checkbox"/> Gamma Ray.	<input type="checkbox"/> Density.
<input type="checkbox"/> Sonic.	<input type="checkbox"/> Neutron.
Other (Describe) _____	
Name of Organization Running Log	

SCREEN DATA		
Diameter - Inches	Length - Feet	Slot Size - Inches
2"	10'	.008
Screen Type	Depth to Bottom - Feet	
PVC	.64'	


GEOLOGIC DATA (Office Use Only)			
Surface Elev.	Geologic Unit	Unit Thickness	Depth to Top
Subs. SWL	Date	Analysis	Aquifer Test
Driller's Remarks			
Top of Lap Pipe or Reduction in Casing			
FEET		IF TELESCOPED OR MORE THAN ONE SCREEN: USE BACK PAGE	

DESCRIPTION OF FORMATIONS ENCOUNTERED	FROM	TO	FORMATIONS (Continued)	FROM	TO
Top Soil	0	2			
Orange clay	2	14			
White coarse sand	14	64			

RECD MAY 17 2001

If well telescopes please
sketch and show depths.

GROUND LEVEL

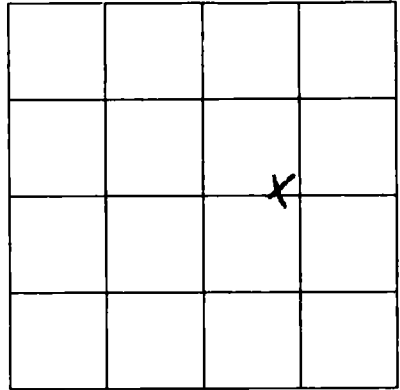

SECTION 23

Please indicate well location X.

ADDITIONAL INFORMATION

If more than one screen,
show location of each on sketch.