

G 25
3-5-61

WATER WELL DRILLERS LOG

Colville

Date: 8/5, 1961, Driller: Water Supply Co County Jackson
44 (Name)

(1) Owner of Land: J Bayley
(Name)
Wade Miss
(Address)

(2) Location: SW 1/4, SW 1/4, Sec. 23 55
18 miles North, of Mass Point
(distance) (direction) (Nearest Town)

(3) Topography: _____
(Hilly) (Flat) (Level)

(4) Purpose of Well: Domestic Irrigation
Municipal, Industrial, Other)

Description & Color of Materials Sand, Clay, Red Clay, Shell, etc.		Thick- ness Feet	Depth Feet
0	SAND	21	Clay
42	SAND	69	

Information upon completion of well:

(1) Diameter 7 inches.

(2) Total Depth 69 feet.

(3) Water Level 25'-9" feet below top of ground.

(4) Cased to _____, Size _____

(5) Screen: Size 2, Length 5'

(6) Were any formations sealed against pollution?
_____ yes, _____ no.

If YES depth of formation _____


Why _____

Drillers Remarks: _____

Depth Form depth form

Water level

25'-9"

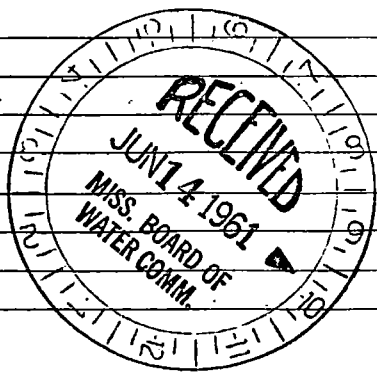

(Use Back Side)

