

G 26

8-28-61

WATER WELL DRILLERS LOG

COLVILLE

Date: 8/28, 1961, Driller: Water Supply Co County JACKSON

49

(1) Owner of Land: B Fisher (Name) Wade Miss (Address)

(2) Location: SW 1/4, SW 1/4, Sec. 11 T5R6W miles of (distance) (direction) (Nearest Town)

(3) Topography: (Hilly) (Flat) (Level) [checked]

(4) Purpose of Well: Domestic Irrigation Municipal, Industrial, Other

Description & Color of Materials Sand, Clay, Red Clay, Shell, etc.	Thick-ness Feet	Depth Feet
0 Red Clay 21 streaks		
52 gravel 100 clay		
228 sand 231 clay		
326 sand 357 iron		

Depth Form Depth Form

WL + 6'

Information upon completion of well:

(1) Diameter 1 1/4 inches.

(2) Total Depth 357 feet.

(3) Water Level + 6 feet below top of ground.

(4) Cased to, Size

(5) Screen: Size 1 1/4, Length 10


(6) Were any formations sealed against pollution? yes, no [checked]

If YES depth of formation

Why

Drillers Remarks:

This well flows about 5 gals per Min

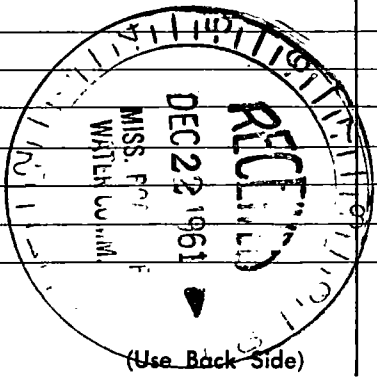

Well No. 49

